


T. 26 S., R. 4 W., W.M.

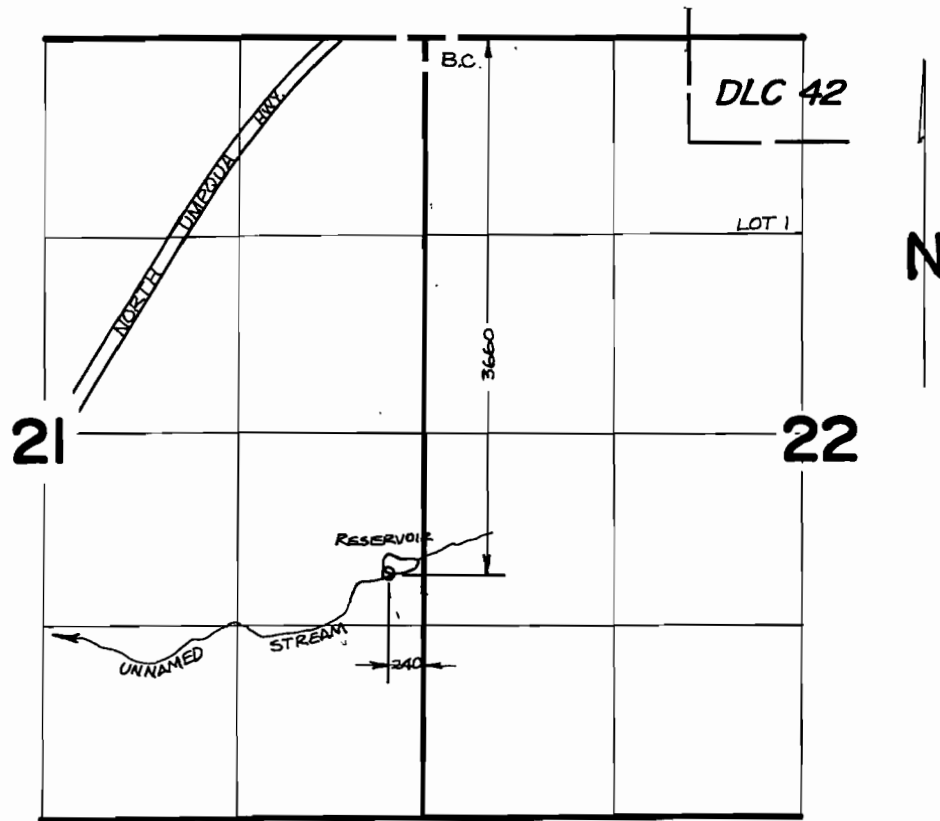

SCALE: 4" = 1 MILE

FINAL PROOF SURVEY UNDER

R-62914 R-8492
Application No. 63254 Permit No. 46977
IN NAME OF

DOUGLAS COUNTY LAND DEPARTMENT

Surveyed SEPT. 4, 19.86, by J.M. SCHMORDE.