


T. 26 S., R. 4 W., W.M.

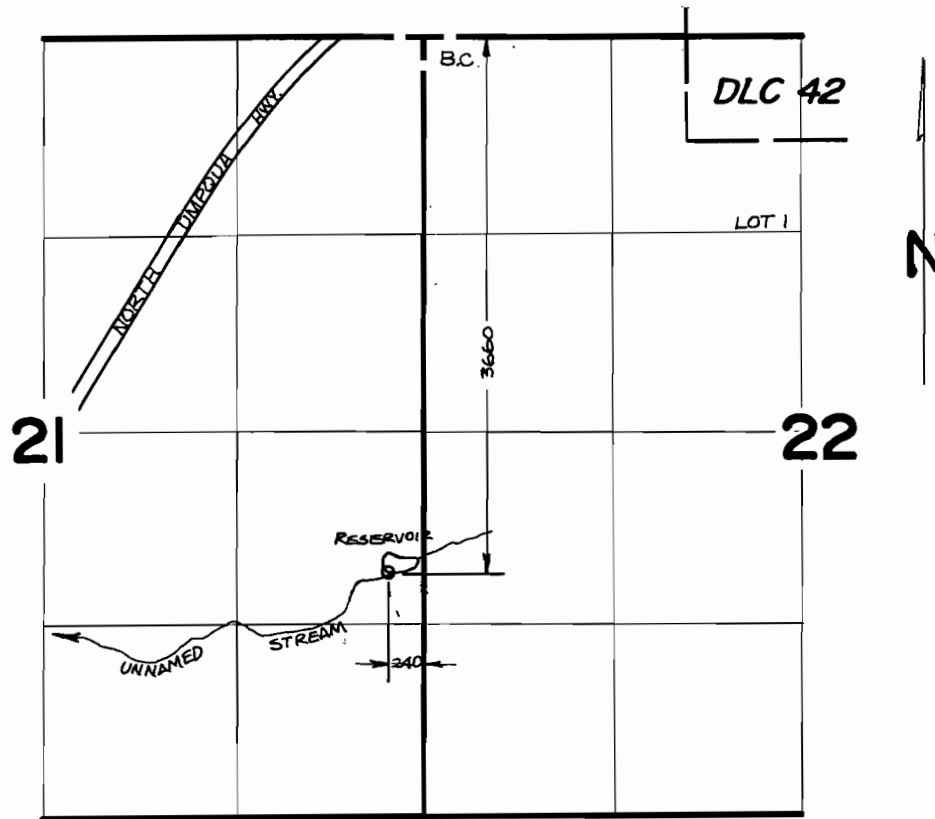

SCALE: 4" = 1 MILE

**FINAL PROOF SURVEY**  
UNDER

R-62914                      R-8492  
Application No. 63254    Permit No. 46977  
IN NAME OF

DOUGLAS COUNTY LAND DEPARTMENT

Surveyed SEPT. 4, 1986, by J.M. SCHMORDE.