TOWNSHIP 18 SOUTH, RANGE 12 EAST, W.M.

SECTION 24

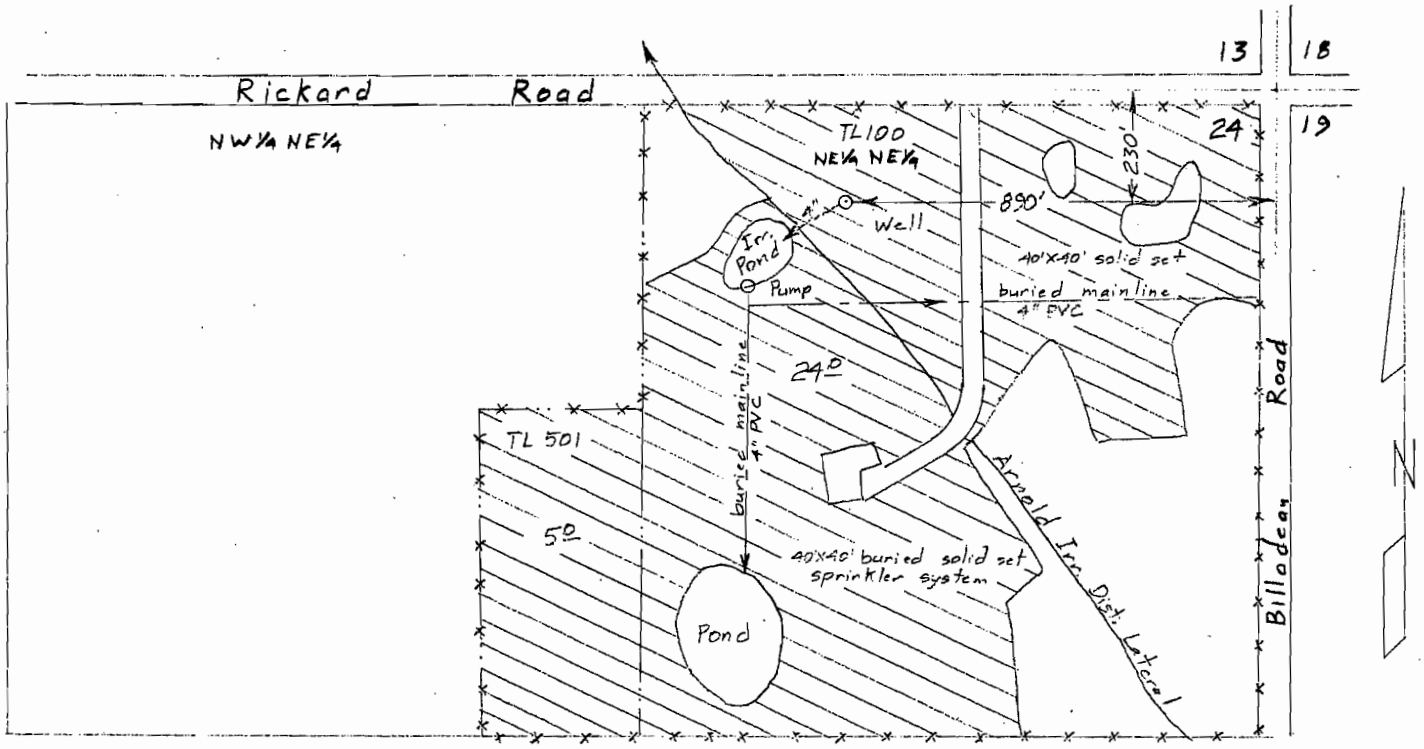

Surveyed September 1, 1998

Scale 1" = 400'

Claim of Beneficial Use Map
for
HAP TAYLOR

RECEIVED
SEP 29 1998
WATER RESOURCES DEPT.
SALEM, OREGON

Application G-13767
Permit G-12742

Certified Water Right Examiner
#1
Bruce A. Estes
Nov. 19, 1987
STATE OF OREGON

This map is for the purpose of locating a water right only and has no intent to provide legal dimensions or the location of property lines.

ESTES SURVEYS
6293 Sunnyview Rd. NE
Salem, OR 97305
(503) 585-7593
60382 Arnold Rd.
Bend, OR 97702
(503) 382-7391