
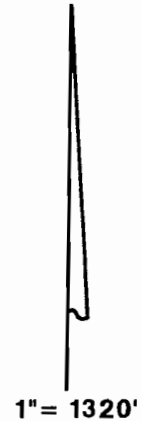


T.8S., R.3W., W.M.

RECEIVED
JUL 09 2009
LAND RESOURCES DEPT
SALEM, OREGON

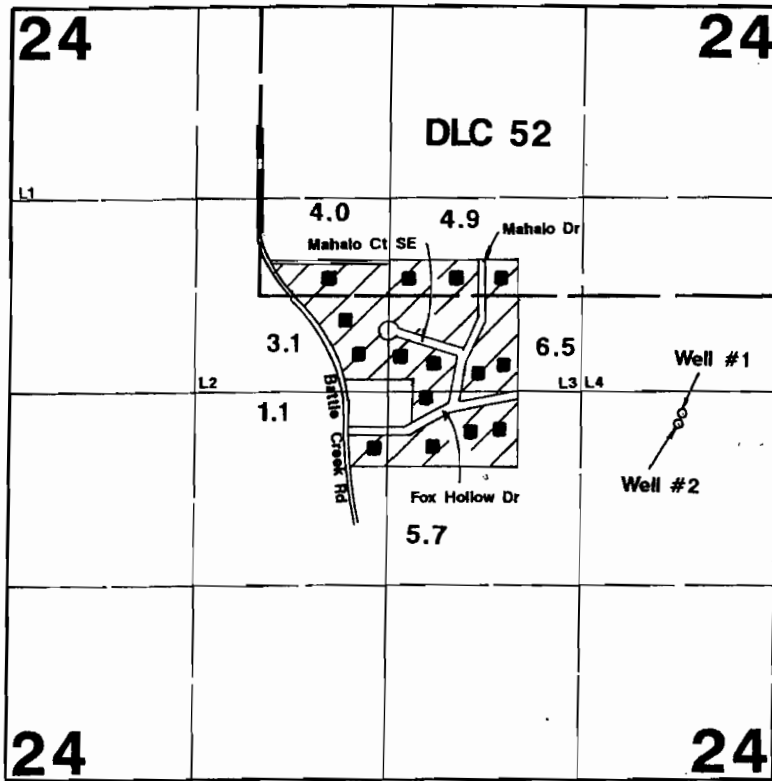

Well #1 located 2500'N & 636'W
Well #2 located 2410'N & 666'W both from SE corner Section 24.

Final Proof Survey

Application #: G-12168 Permit #: G-11393

In Name Of

Fox Hollow Estates Water Corp.

Surveyed on September 24, 1997 by JM Schuette



THIS MAP WAS PREPARED FOR THE PURPOSE OF IDENTIFYING THE LOCATION OF A WATER RIGHT ONLY AND IS NOT INTENDED TO PROVIDE LEGAL DIMENSIONS OR LOCATION OF PROPERTY OWNERSHIP LINES.