


SECTION 4 & 5 T.5S., R.2W., W.M.
MARION COUNTY, OREGON

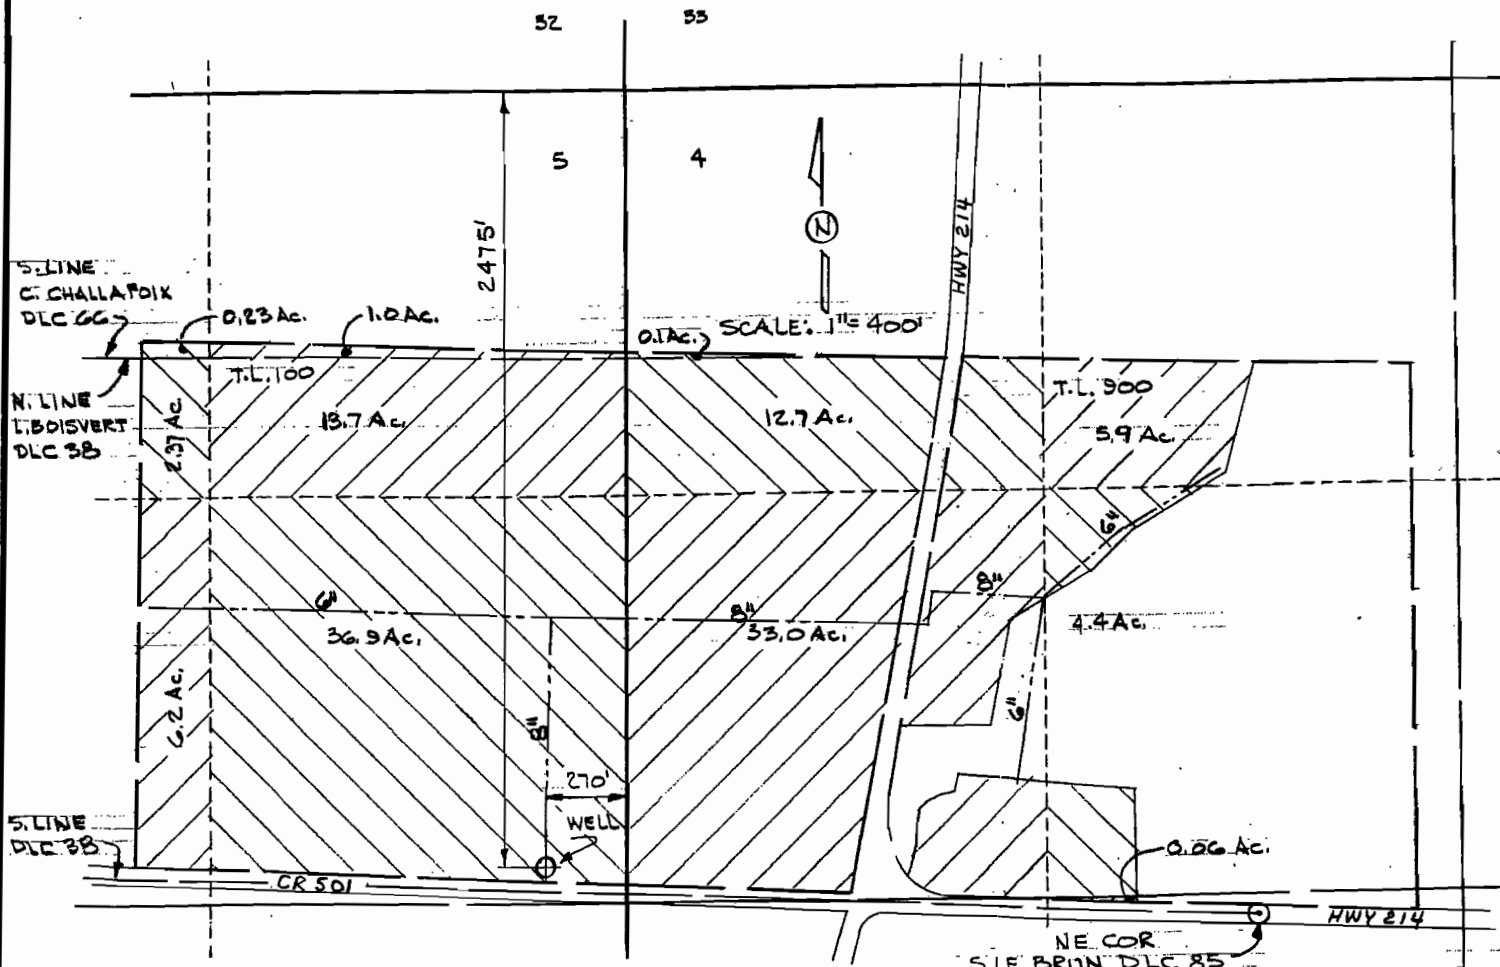

FINAL PROOF SURVEY RECEIVED
 APPLICATION G-12763
 PERMIT G-12081
 SURVEYED 6-11-97
 RESOURCES DEPT.
 SALEM, OREGON
 APR 09 1998

GARY & HEIDI VACHTER
 17124 FRENCH PRAIRIE ROAD
 ST. PAUL, OR 97137

	date
designed	WRV 4-6-98
drawn	JBE 4-6-98
checked	WRV 4-6-98
drawing no.	98-5-04
sheet no.	1/1

VERBOORT ENGINEERING
 AGRICULTURE - CIVIL - WATER RESOURCES
 HILLSBORO, OREGON



PREPARATION OF THIS MAP IS FOR THE PURPOSE OF IDENTIFYING THE LOCATION OF THE WATER RIGHT ONLY. THERE IS NO INTENT TO PROVIDE DIMENSIONS OR LOCATION OF PROPERTY OWNERSHIP LINES.

MAP BASE
 MARION COUNTY
 ASSESSOR & ASCS
 PHOTOGRAPHY