


RECEIVED

APR 24 1998

WATER RESOURCES DEPT.
SALEM, OREGON

T 31 S, R 31 E, WM

15

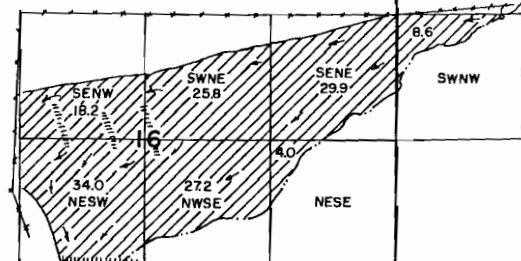


THE PURPOSE OF THIS MAP IS TO
IDENTIFY THE LOCATION OF THE
WATER RIGHT. IT IS NOT INTENDED
TO PROVIDE INFORMATION RELATIVE
TO THE LOCATION OF PROPERTY
OWNERSHIP.

N

22

23

24

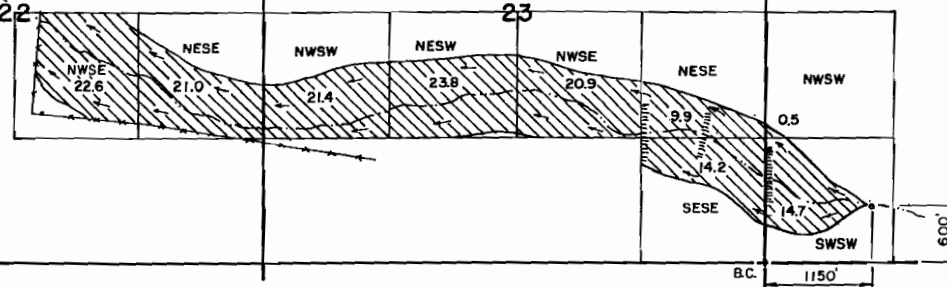

	FINAL PROOF SURVEY		
	UNDER: APPLICATION NO. S-70443 PERMIT NO. 52806		IN THE NAME OF HARVEY G. & MARGARET P. DUNBAR
	Scale: 4" = 1 MILE	Date: APRIL 20, 1998	Job: 1234
	Dgn: Drn: CHRIS Ckd:	M. A. PALMER & SONS, INC. ENGINEERING & SURVEYING 254 N. Alder - Box 61 Burns, Oregon 97720	