

T 16 S, R 3 E, W.M.

THE PURPOSE OF THIS MAP IS TO IDENTIFY THE LOCATION OF THE WATER RIGHTS. IT IS NOT INTENDED TO PROVIDE INFORMATION RELATIVE TO THE LOCATION OF PROPERTY OWNERSHIP BOUNDARY LINES.



RECEIVED

MAY 20 1998

WATER RESOURCES DEPT.
SALEM OREGON



SCALE: 1" = 400'

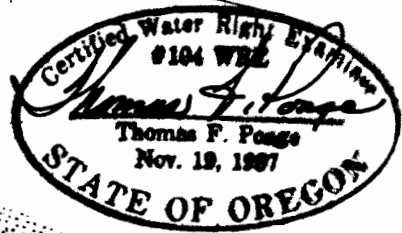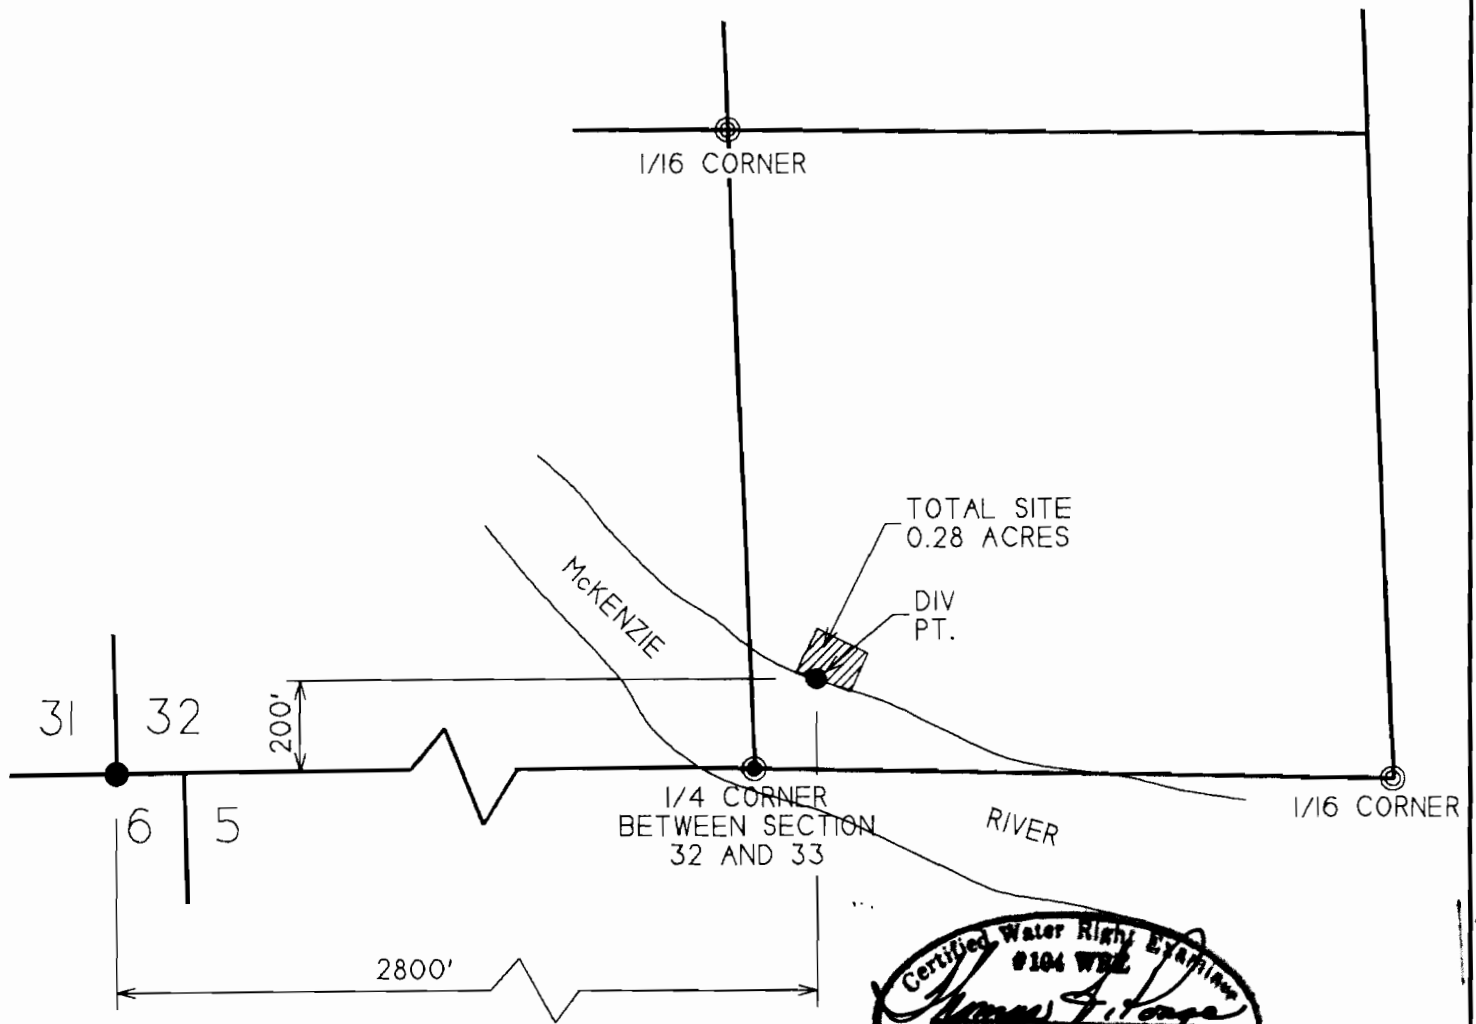

FINAL PROOF SURVEY
UNDER

APPLICATION NO. S-71809

PERMIT NO. S-51638

IN THE NAME OF

HOLLIS AND PRISCILLA OXLEY

CADD FILE: 1666PROF.GCD

COGO FILE: 1666

DRAWN: 4/30/98 DPS