


T. 27S., R. 5W., W. M.

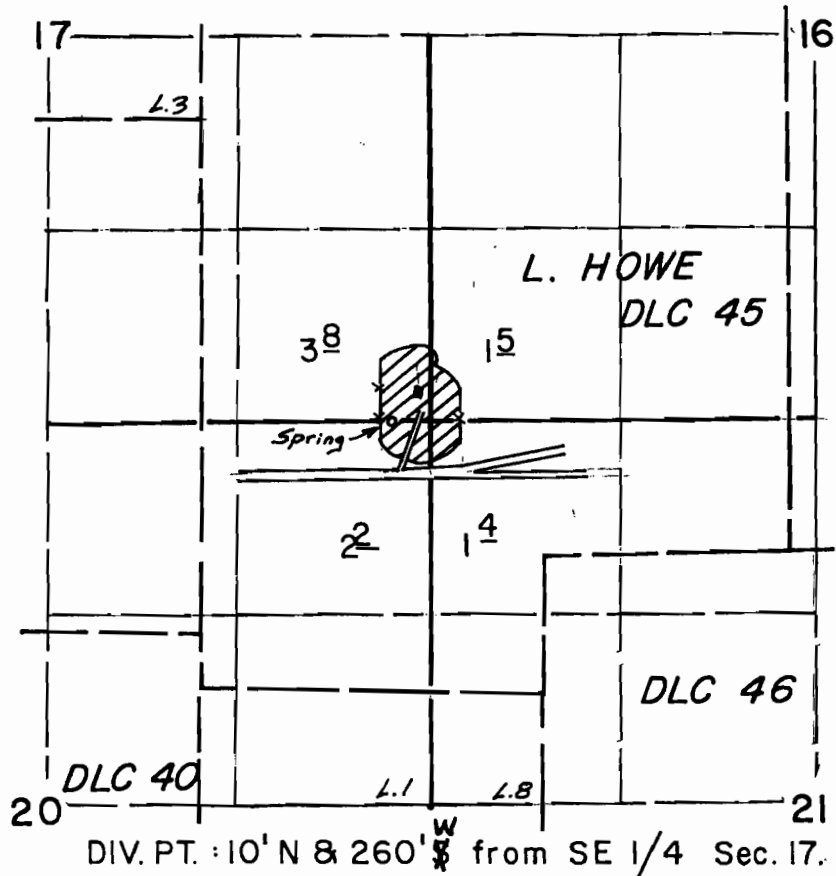

Scale 1" = 1320'

**FINAL PROOF SURVEY**  
UNDER

Application No. 64328 Permit No. 47139...  
IN NAME OF

ROSEBURG FIRST CHURCH OF THE NAZARENE

Surveyed Aug. 7, 1995, by B.S. DeHaas