

FINAL PROOF MAP

UNDER

APPLICATION No. 73232 PERMIT No. 51630

IN THE NAME OF:

Judy L. Whitley


50378 OR HWY 203

Baker City, OR 97814

T7S R41E

C1/4

1/4

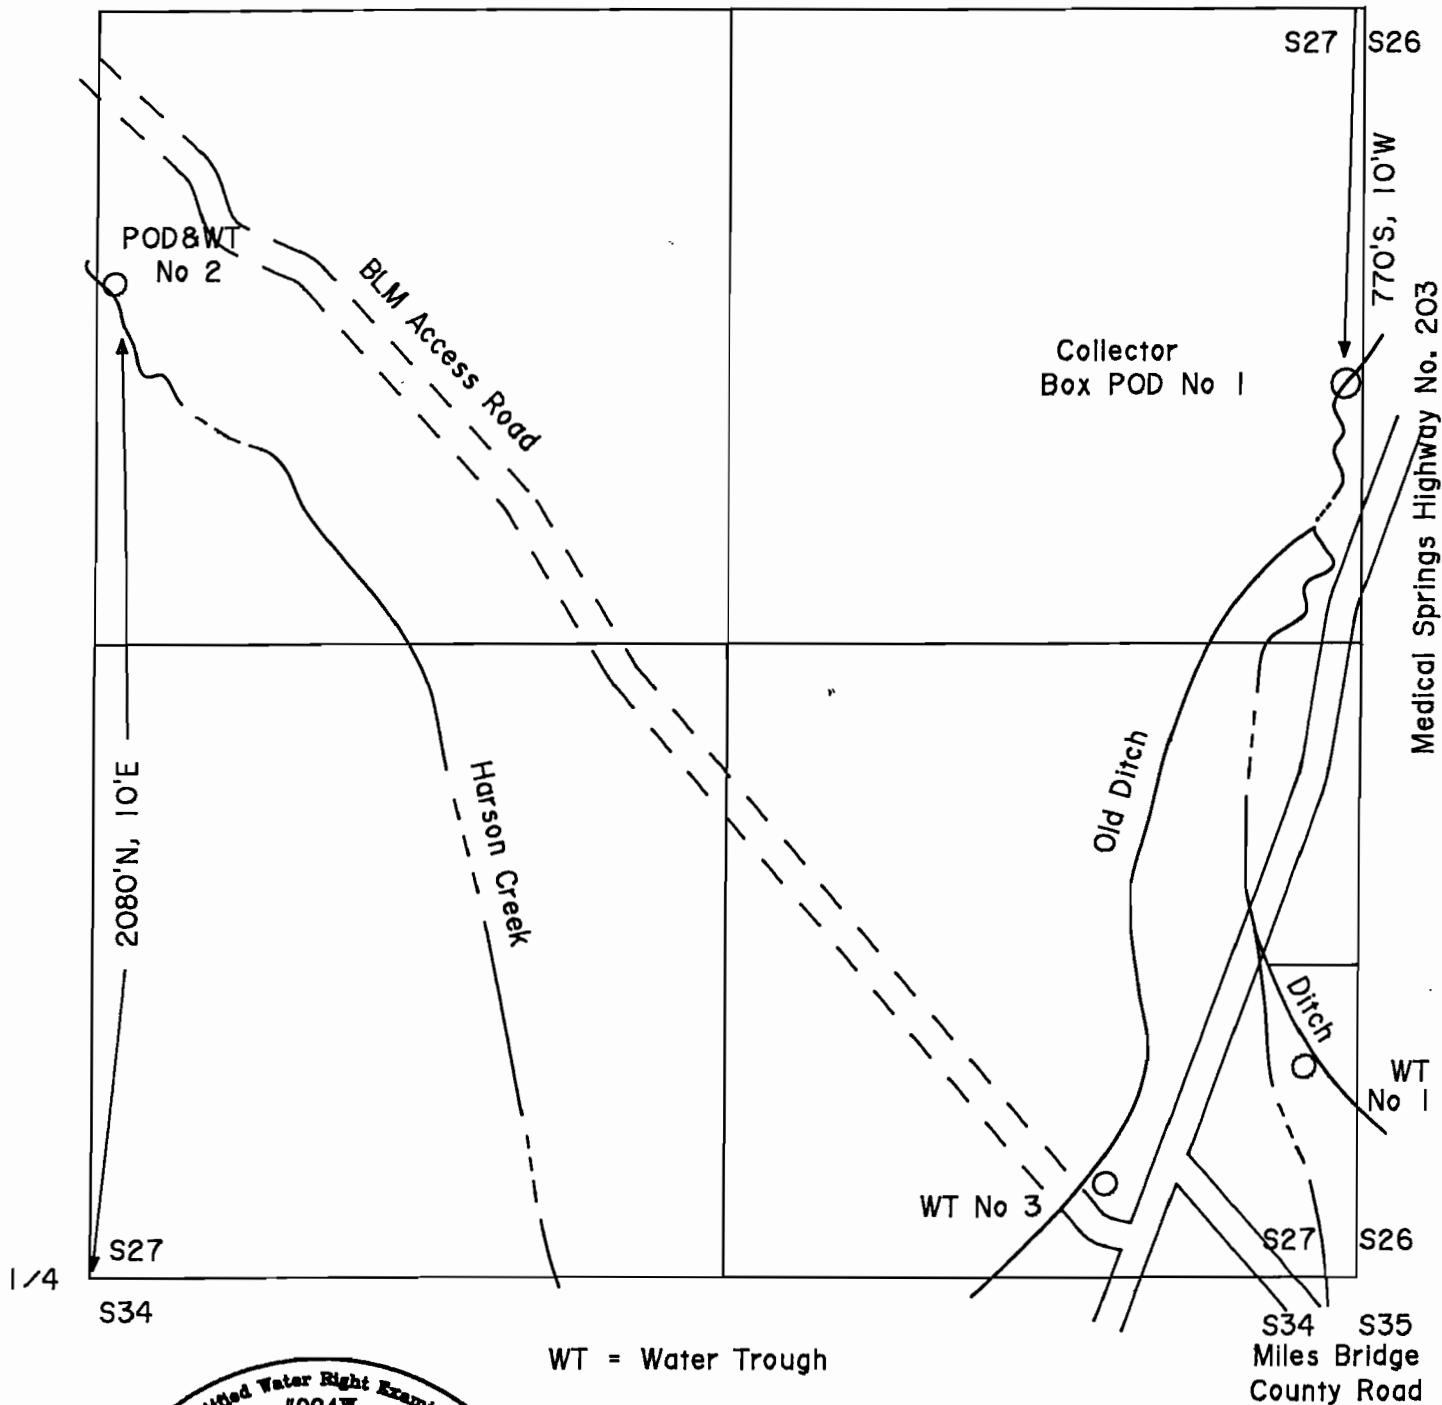

WT = Water Trough



Scale 1" = 400'

This map is for the purpose of identifying the location of the water right only and has no intent to provide dimensions or location of property ownership lines.

1987