


RECEIVED


JUL 6 - 1999

WATER RESOURCES DEPT.
SALEM, OREGON

T. 7 S., R. 38 E., W.M.

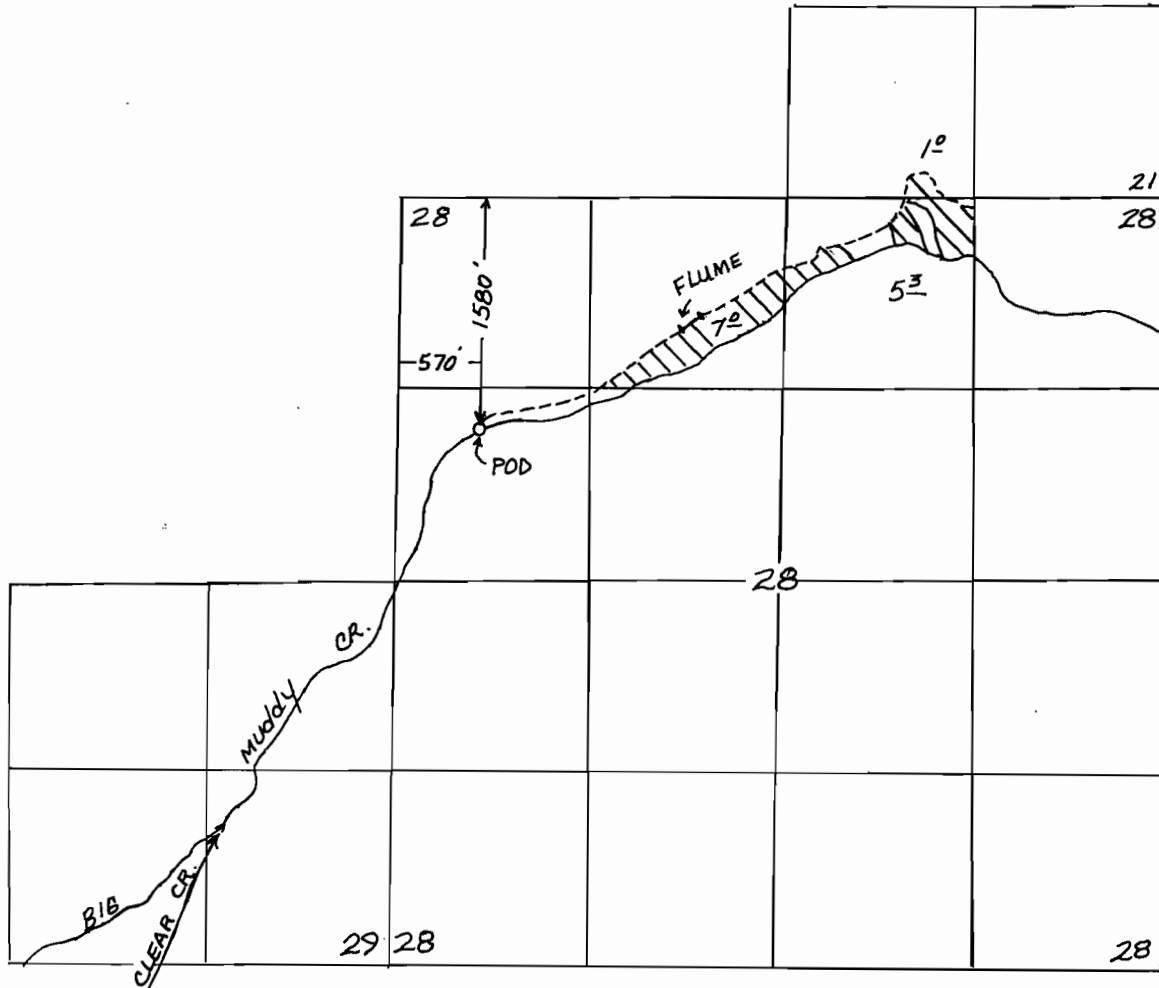

1" = 1320'

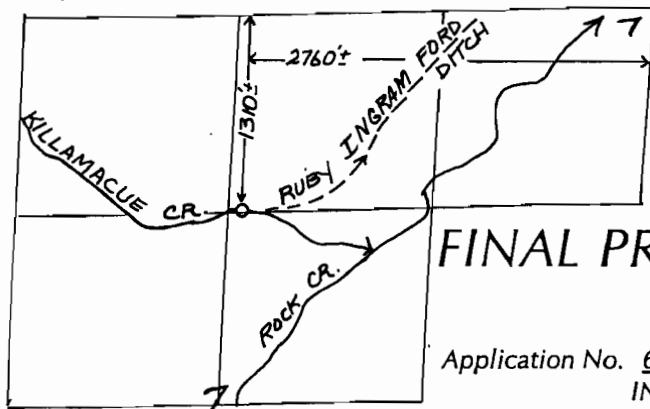

T8S, R 38 E, W.M.

FINAL PROOF SURVEY

UNDER

Application No. 67904 Permit No. 48341
IN NAME OF

TOMMY L. DUNCAN AND RICHARD CAMP

Surveyed AUGUST 4, 1994, by J. MILLER