


T. 5 N.,
R. 1 W., W.M.

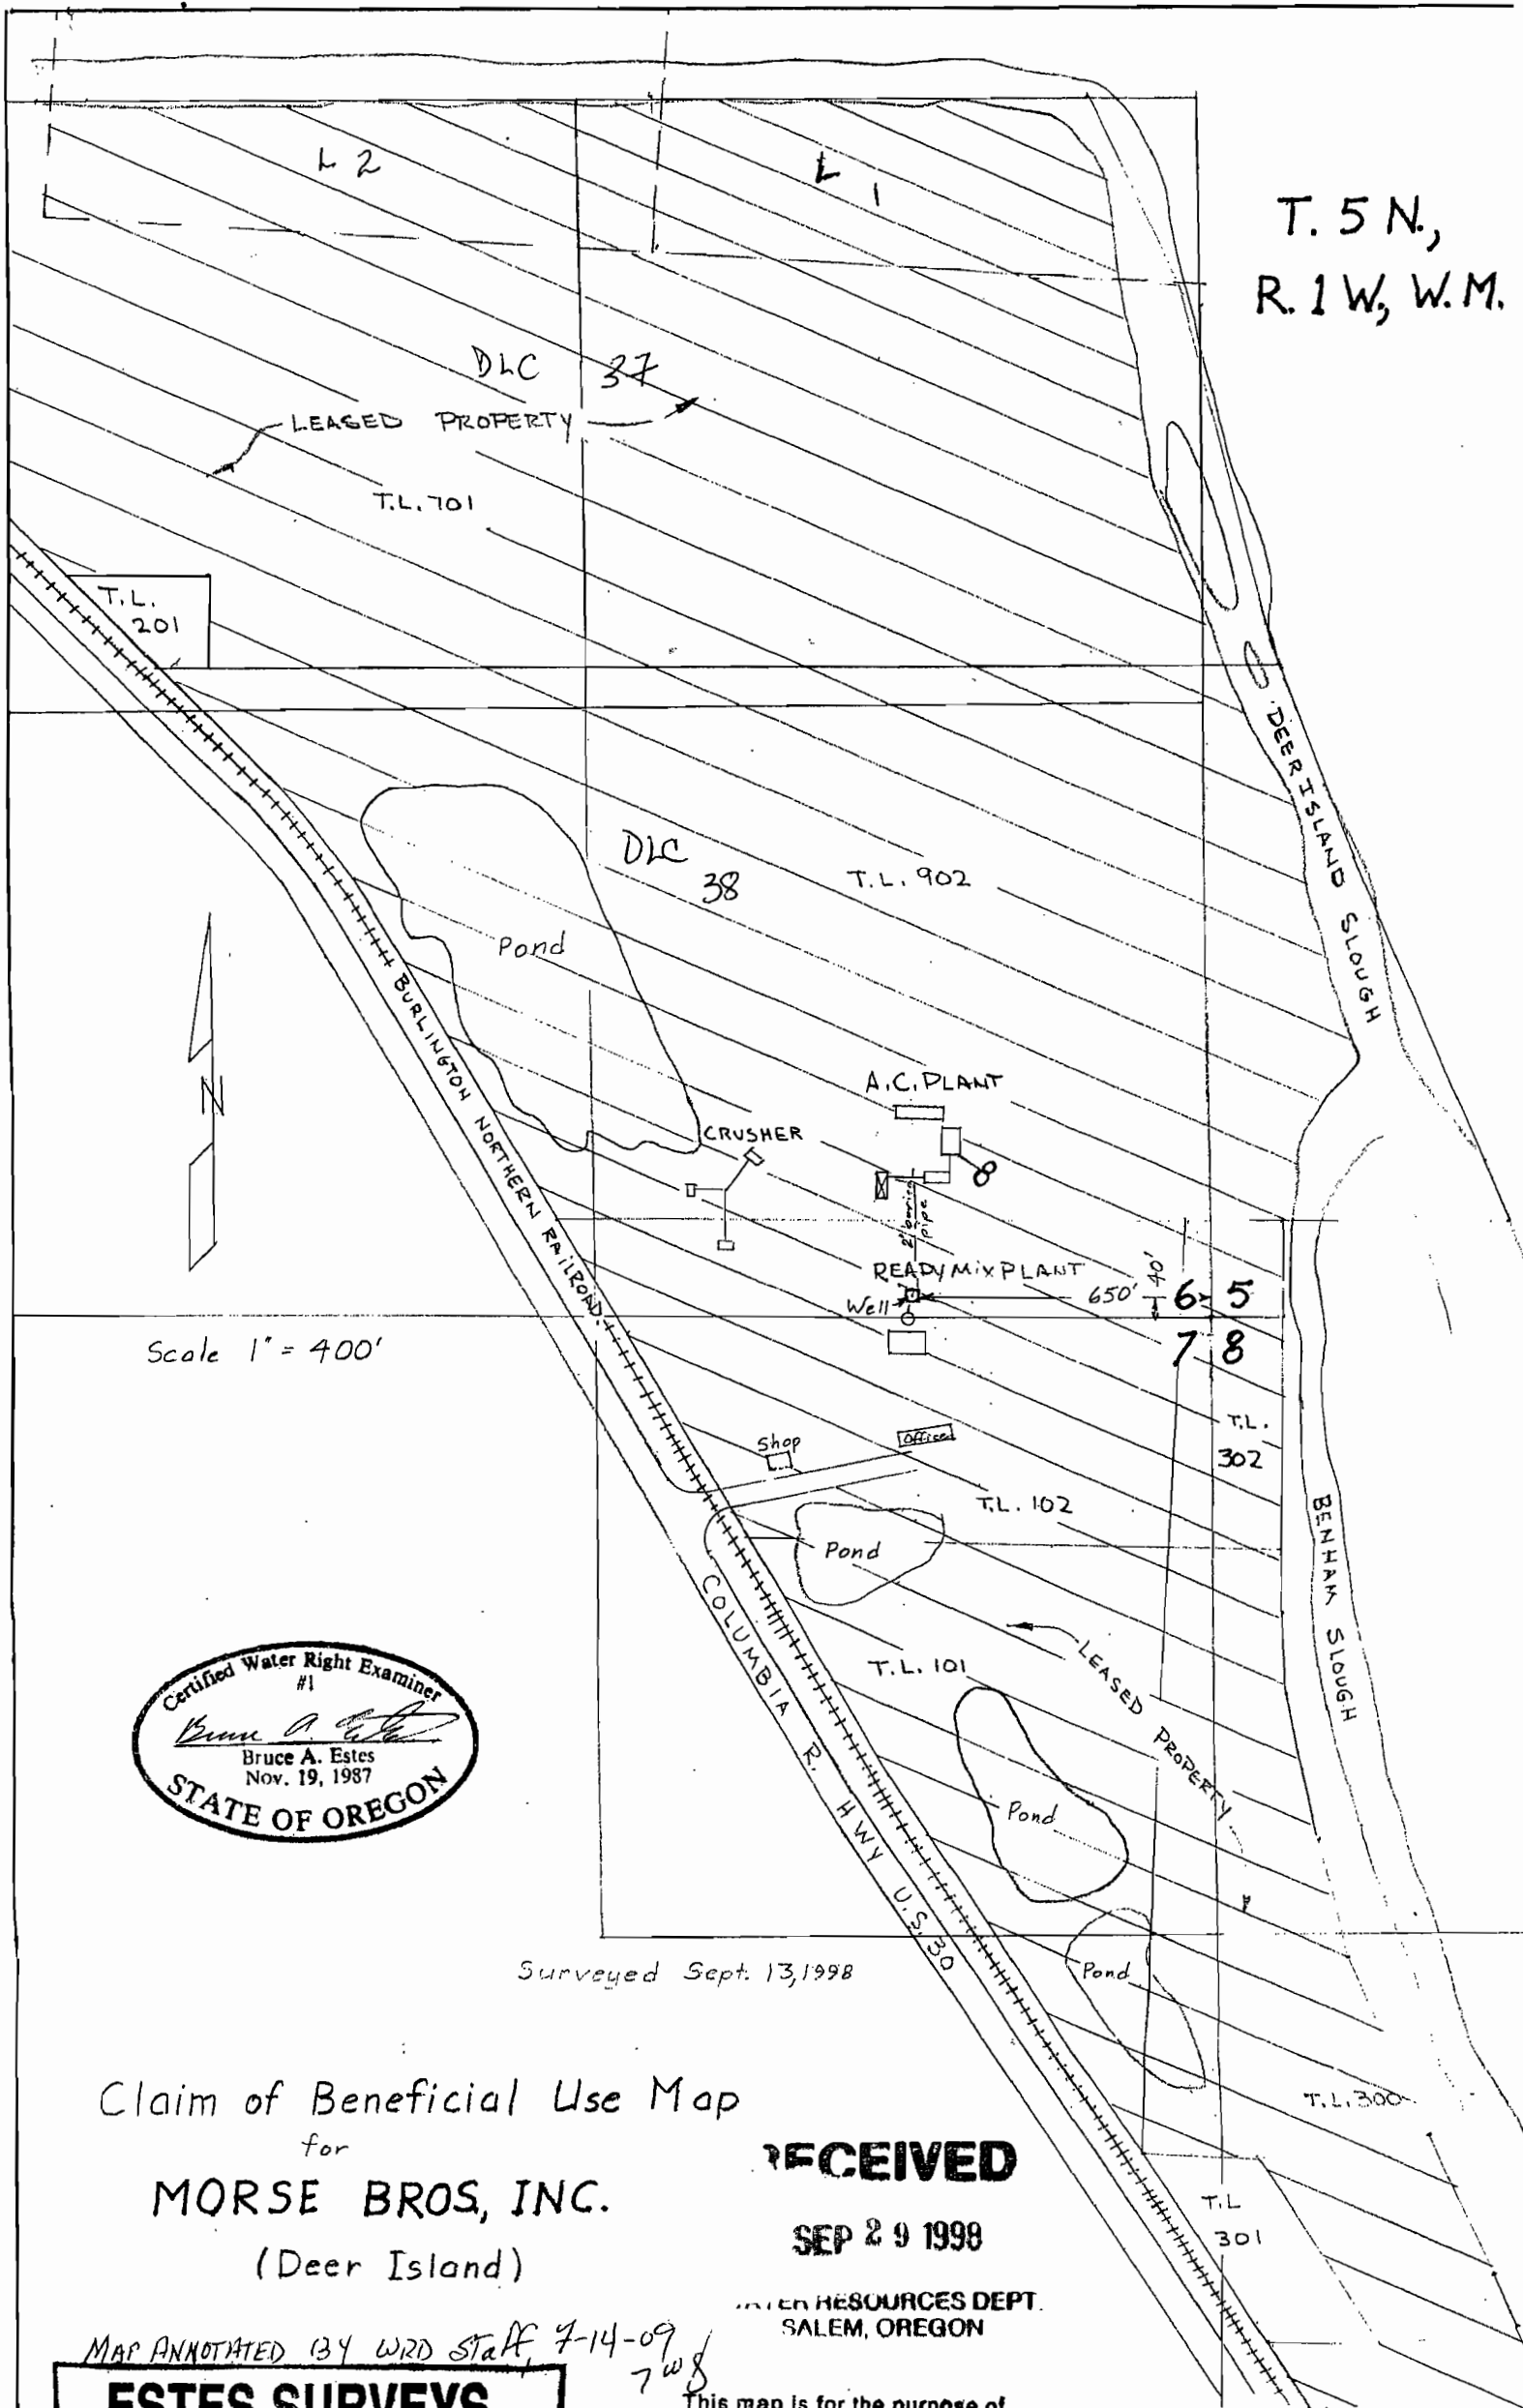

Claim of Beneficial Use Map
for
MORSE BROS, INC.
(Deer Island)

RECEIVED

SEP 29 1998

WATER RESOURCES DEPT.
SALEM, OREGON

MAP ANNOTATED BY WRD STAFF 7-14-09
7w8

ESTES SURVEYS

6293 Sunnyview Rd. NE 60382 Arnold Rd.
Salem, OR 97305 Bend, OR 97702
(503) 585-7593 (503) 382-7391

This map is for the purpose of
locating a water right only
and has no intent to provide
legal dimensions or the location
of property lines.

App G-13496
Per G-11865