


T.6S. R.3W., W.M


RECEIVED

JUL 28 1998

WATER RESOURCES DEPT.
SALEM, OREGON

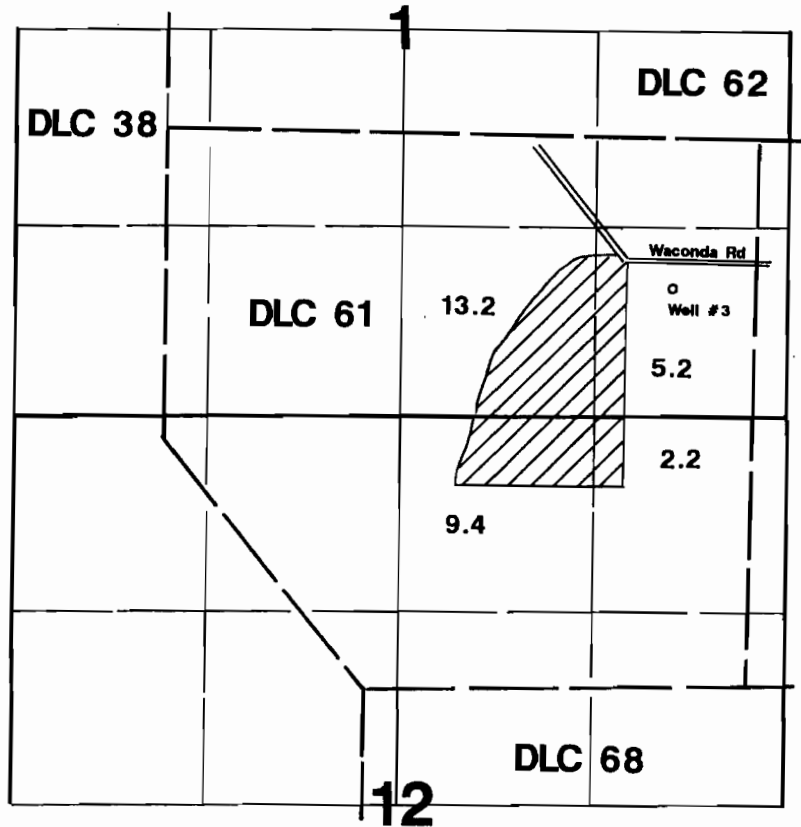

1" = 1320'

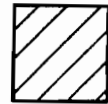

Area Irrigated

Well # 3 is located 980'S & 600'W from NE corner of DLC 61.

Final Proof Survey

Application #: G-14448 Permit #: G-13330

In Name Of

Ted V. Bell

Surveyed on July 20, 1998 by JM Schuette

This Map Was Prepared For The Purpose Of Identifying The Location Of A Water Right Only And Is Not Intended To Provide Legal Dimensions Or Location Of Property Ownership Lines.

