


T. 39 S., R. 13 E., W.M.

**RECEIVED**

FEB - 2 1998


WATER RESOURCES DEPT.  
SALEM, OREGON

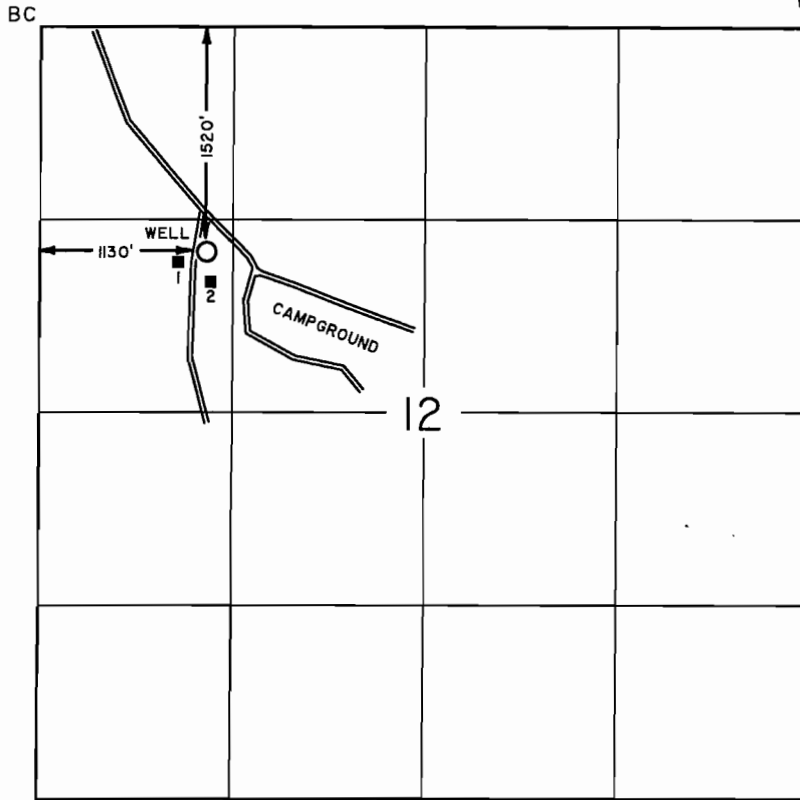

1" = 1320'

1-BOR HOUSE  
2-GARAGE

FINAL PROOF MAP  
UNDER

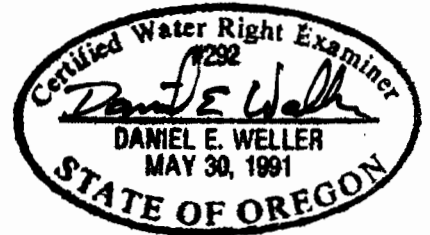

APPLICATION NO. G-13134      PERMIT NO. G-12710

IN NAME OF  
UNITED STATES BUREAU OF LAND MANAGEMENT

SURVEYED: AUGUST 13, 1997

THE PURPOSE OF THIS MAP IS FOR IDENTIFYING THE LOCATION OF THE WATER RIGHT ONLY AND IS NOT INTENDED TO PROVIDE LEGAL DIMENSIONS OR LOCATION OF PROPERTY OWNERSHIP LINES.

BLM PROJECT NO. OR-010-R-4982

DWG:RECLAMAT

WRE 6034AOREGON

U.S. BUREAU OF LAND MANAGEMENT-OSO  
BRANCH OF CADASTRAL SURVEY  
LETTER OF AUTHORIZATION  
DATED: AUGUST 29, 1997

EXECUTED BY:  
DANIEL E. WELLER, PLS, CWRE  
P.O. BOX 2965  
PORTLAND, OREGON 97208