


T. 39 S., R. 13 E., W.M.

RECEIVED

FEB - 2 1998

WATER RESOURCES DEPT.
SALEM, OREGON


Gerber Recreation Well
point of diversion is
150 ft North and 1120
ft West of the SE
corner of Section 2.

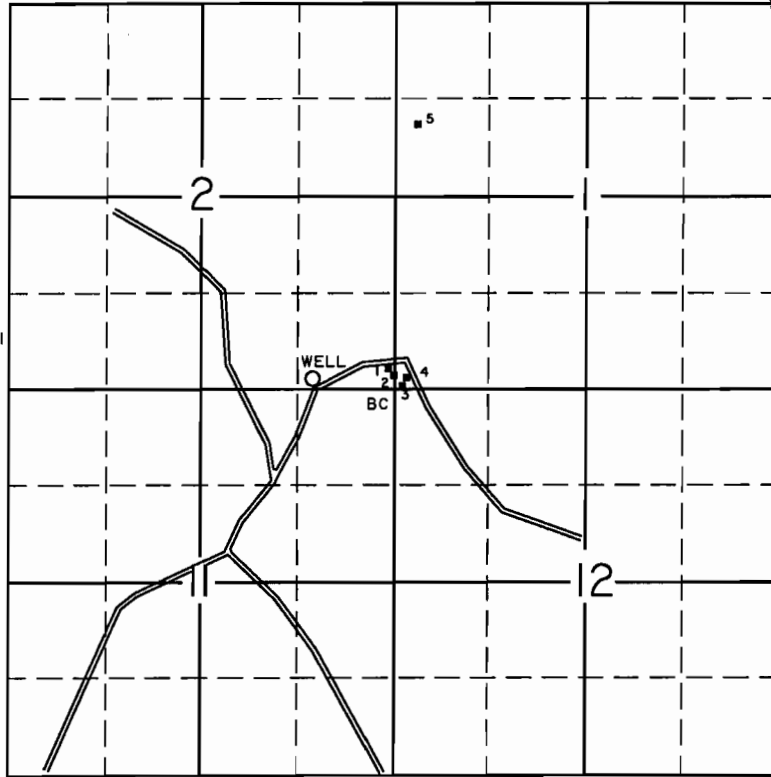

1" = 2640'

- 1-PUMPER GARAGE
- 2-GUARD STATION
- 3-BUNKHOUSE
- 4-BUNKHOUSE
- 5-RECREATION CAMPGROUND

FINAL PROOF MAP
UNDER

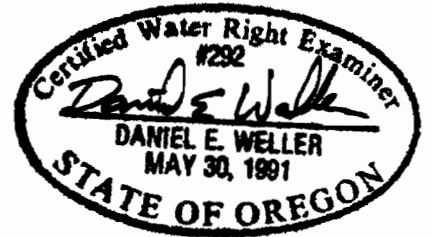

APPLICATION NO. G-13136 PERMIT NO. G-12974

IN NAME OF
UNITED STATES BUREAU OF LAND MANAGEMENT

SURVEYED: AUGUST 13, 1997

THE PURPOSE OF THIS MAP IS FOR IDENTIFYING THE LOCATION OF THE WATER RIGHT ONLY AND IS NOT INTENDED TO PROVIDE LEGAL DIMENSIONS OR LOCATION OF PROPERTY OWNERSHIP LINES.

BLM PROJECT NO. OR-010-R-4263

DWG:RECREATI

WRE 6027A OREGON

U.S. BUREAU OF LAND MANAGEMENT-OSO
BRANCH OF CADASTRAL SURVEY
LETTER OF AUTHORIZATION
DATED: AUGUST 29, 1997

EXECUTED BY:
DANIEL E. WELLER, PLS, CWRE
P.O. BOX 2965
PORTLAND, OREGON 97208