


T.14S.R.15E.W.M.

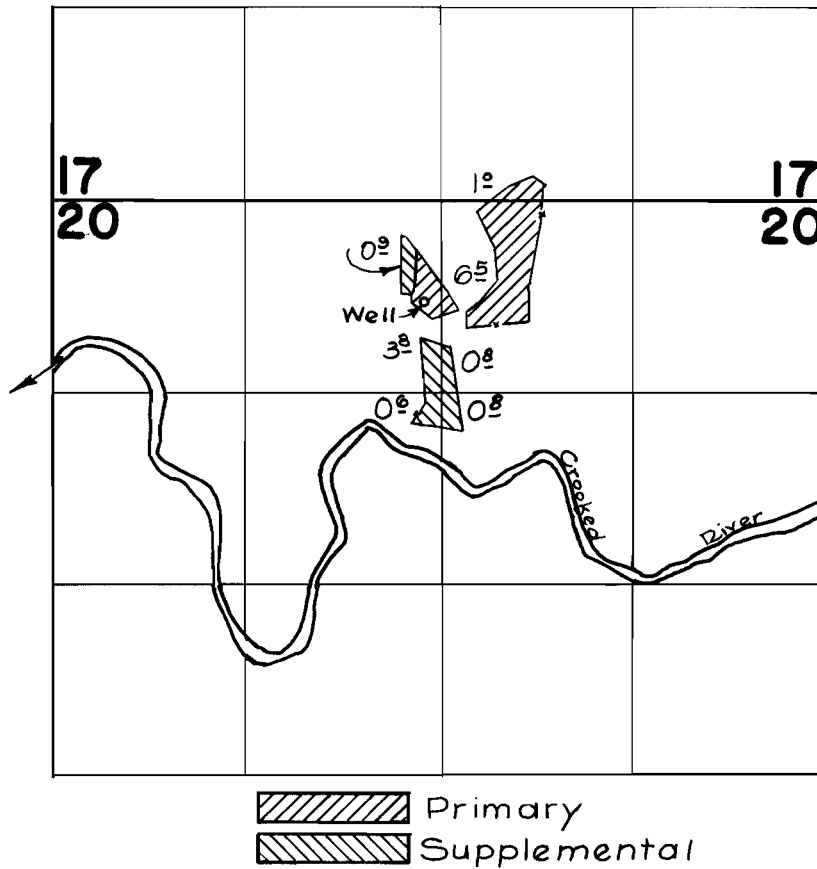

FINAL PROOF SURVEY UNDER

Application No. G-1239. Permit No. G-1119...
IN NAME OF

ROBERT LISTER

Surveyed Nov. 2, 1962, by C. R. BAKER
July 8, 1963, by T. LAUER