


T. 7 N., R. 2 W., W.M.

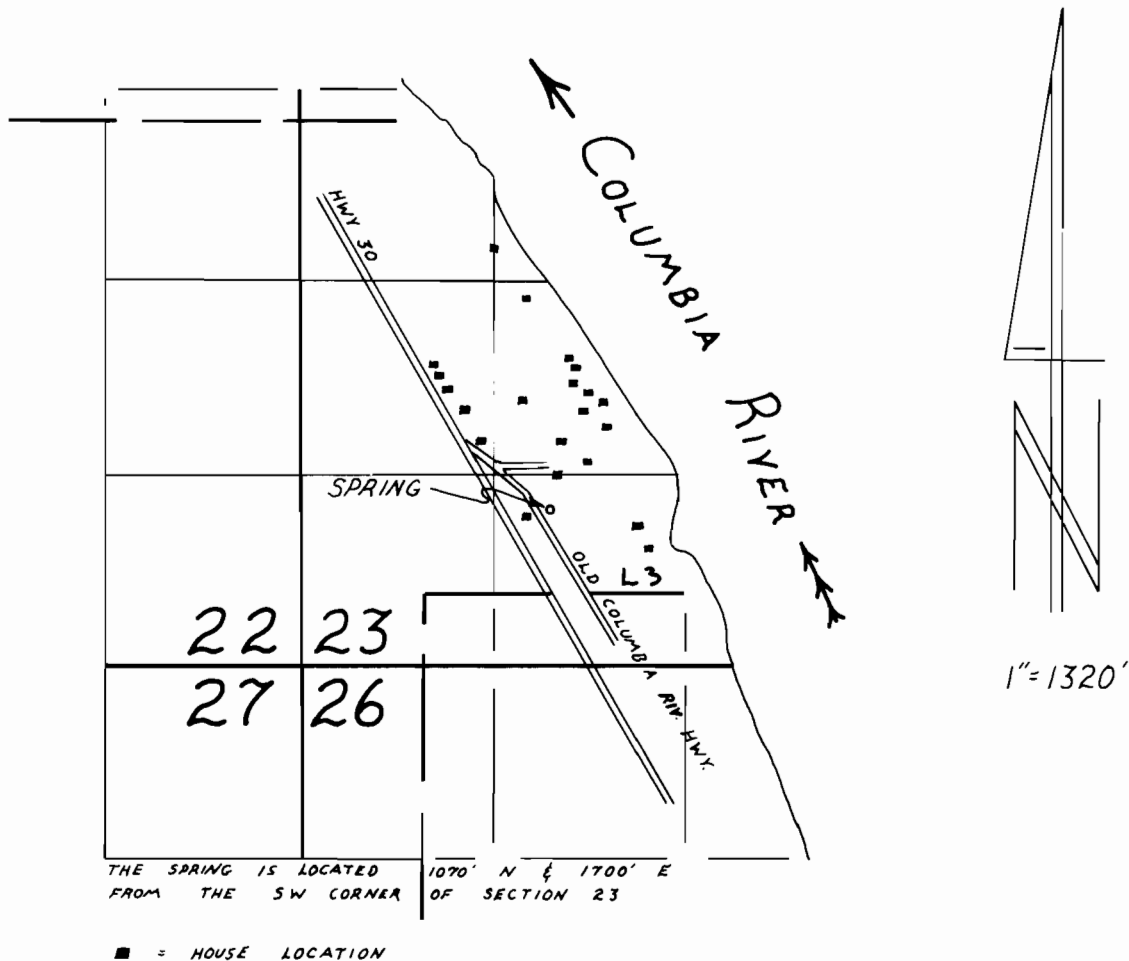

FINAL PROOF SURVEY

UNDER

Application No. 50093 Permit No. 38084
IN NAME OF

Paul G. & Natrona K. Jacobs

Surveyed May 6, 1994, by R.W. Klassen