


T. 9 S., R. 25 E., W.M.

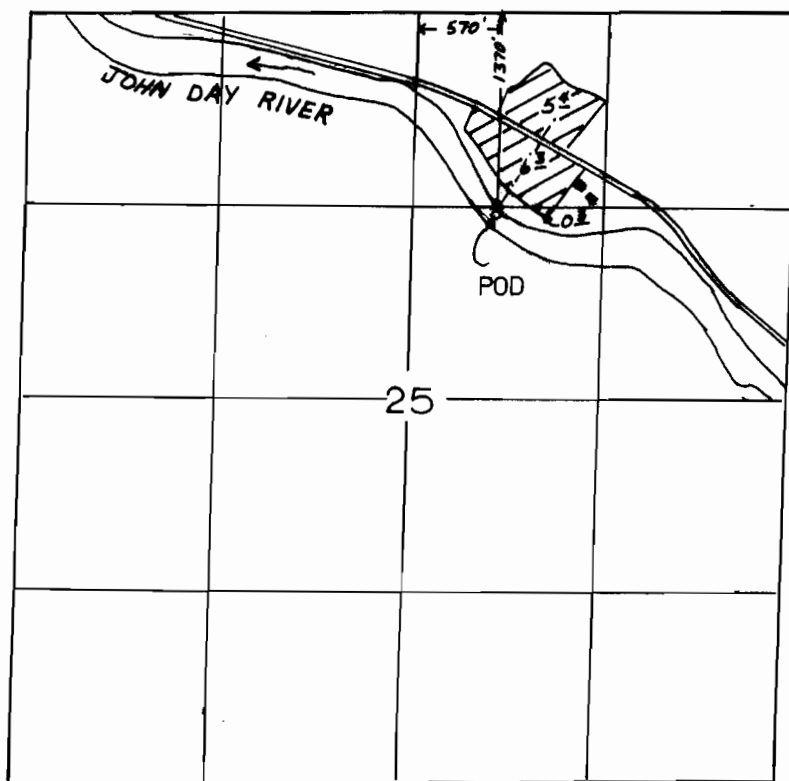

1"=1320'

FINAL PROOF SURVEY

UNDER

Application No. 50176 Permit No. 38085
IN NAME OF

FRANK J. AND SUE M. JANKUNIS

Surveyed 4-16, 1992, by L. MILLER