

City of Pendleton, Oregon
Water Distribution System

Claim of Beneficial Use

Township 2N, Range 32E, W.M.


Transfer # T-8761
Permit: S-472, S-1197, S-9006, S-9007


Transfer # T-8721
Permit: Umatilla River Decree D-2582

Transfer # T-8640
Permit: Umatilla River Decree D-2604

Legal Description
Point of Diversion is 297' South and 679' East of the N1/4 corner of Section 12, Township 2N, Range 32E, W.M.

- Notes:
1. The required fish screen is part of the intake structure extending into the Umatilla River.
 2. The required flow meter is located at the inlet to the Water Treatment Plant.
- This map is not intended to provide legal dimensions or locations of property ownership lines.

 - Service Area

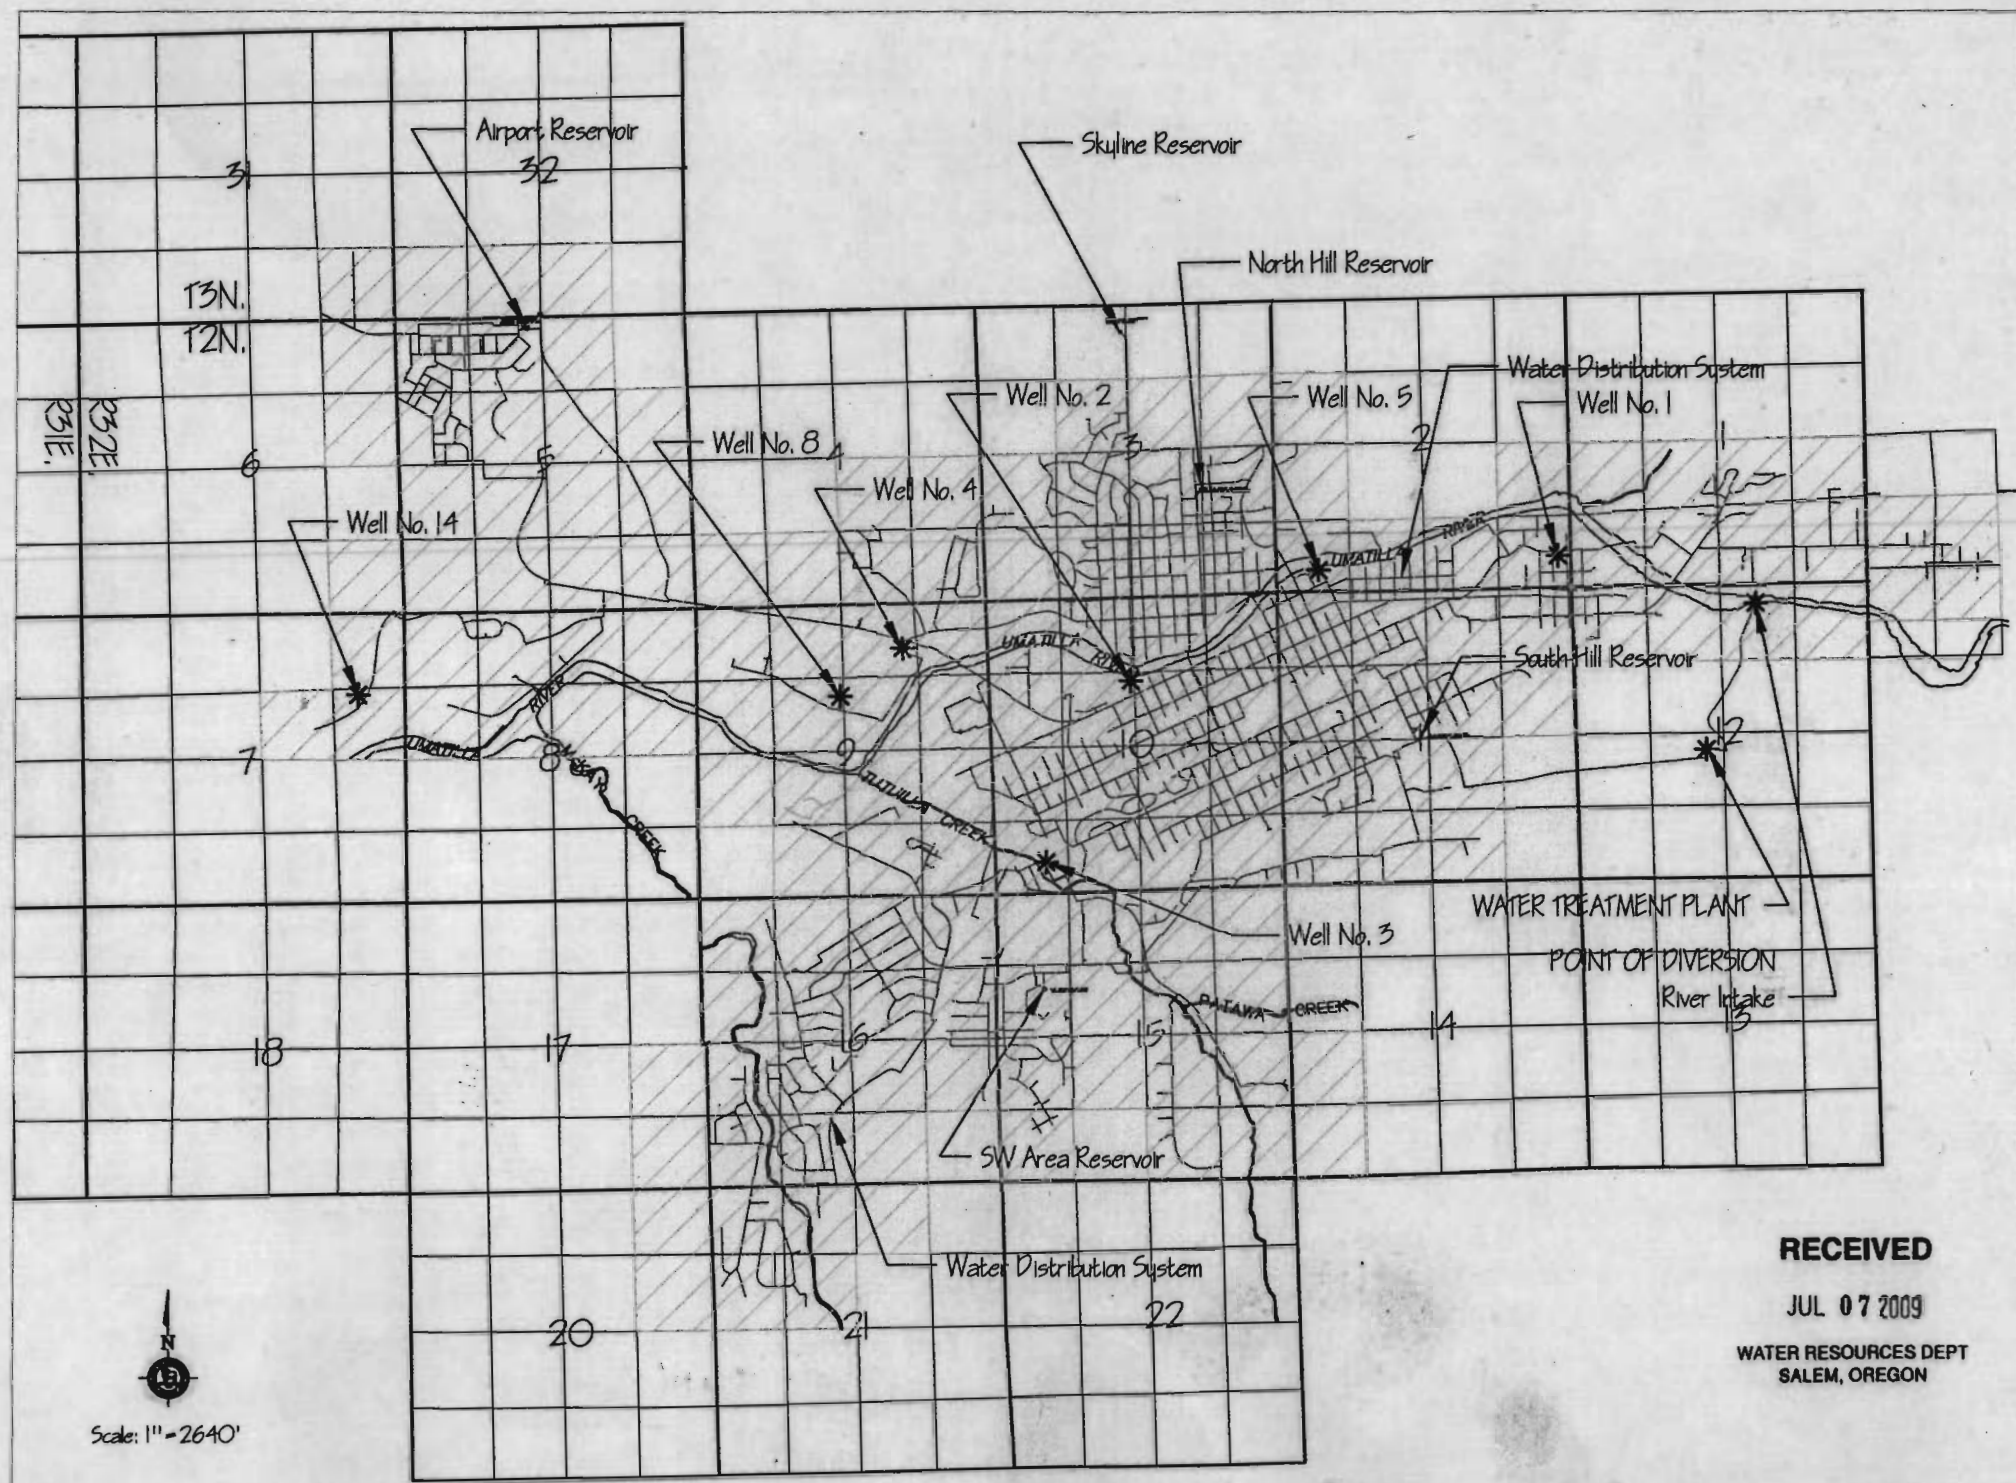

RECEIVED
JUL 07 2009
WATER RESOURCES DEPT
SALEM, OREGON



January 27, 2009
Drawn By: WCG

COBU MAP #0441 3 of 4