


T.14S.R.15E.W.M.

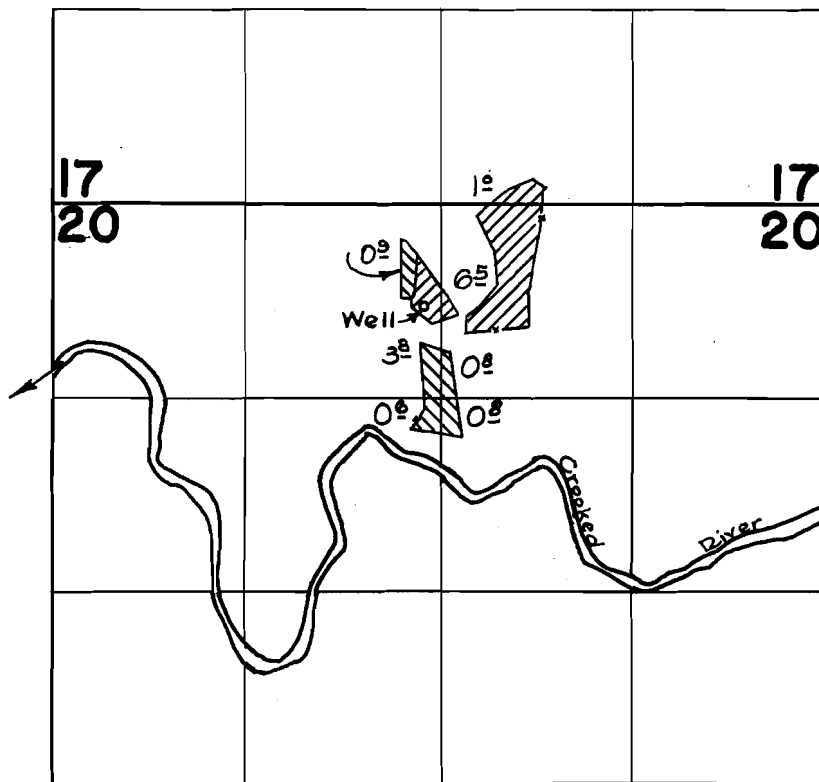

 Primary
 Supplemental

FINAL PROOF SURVEY UNDER

Application No. ~~G-1239~~ Permit No. ~~G-1119~~
IN NAME OF

ROBERT LISTER

Surveyed Nov. 2, 1962, by C. R. BAKER
July 8, 1963 by T. LAUER