


RECEIVED

MAY 29 1998

WATER RESOURCES DEPT.
SALEM, OREGON




SCALE 1" = 1320'

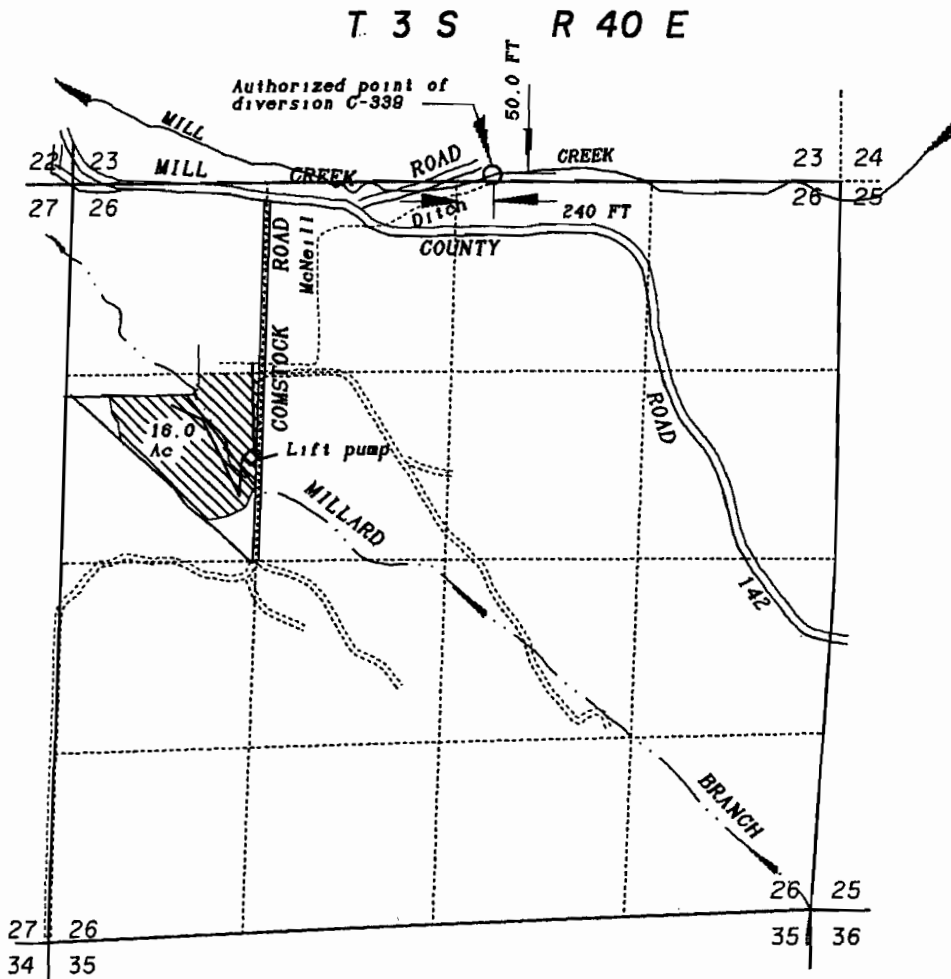

Lands being irrigated under Transfer No. 7667



Existing 6" mainline

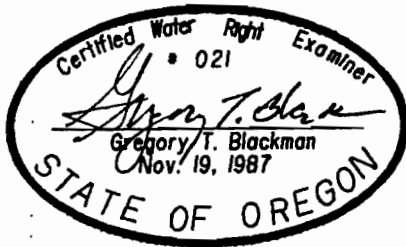

NOTE: The preparation of this map was for the purpose of identifying the location of the proposed water right and has no intent to provide dimensions or location of property ownership lines. Location information shown hereon was furnished by the applicant.

FINAL PROOF FOR
TRANSFER OF PLACE OF USE
FOR
KENNETH D. & JEANETTE S. KNOTT
BY
BAGETT - GRIFFITH & BLACKMAN
2006 ADAMS AVENUE
LAGRANDE, OREGON 97850

May 19, 1998

APPLICATION NO. T- 7667

PERMIT NUMBER T- 7667