


CLAIM OF BENEFICIAL USE MAP
FOR PERMIT R-13957
IN THE NAME OF ARCHES PLACE LLC
(RESERVOIRS R5, R6, R7 & R8)
SEC'S 26, 27, 34 & 36, T4S, R20E, WM
GILLIAM COUNTY

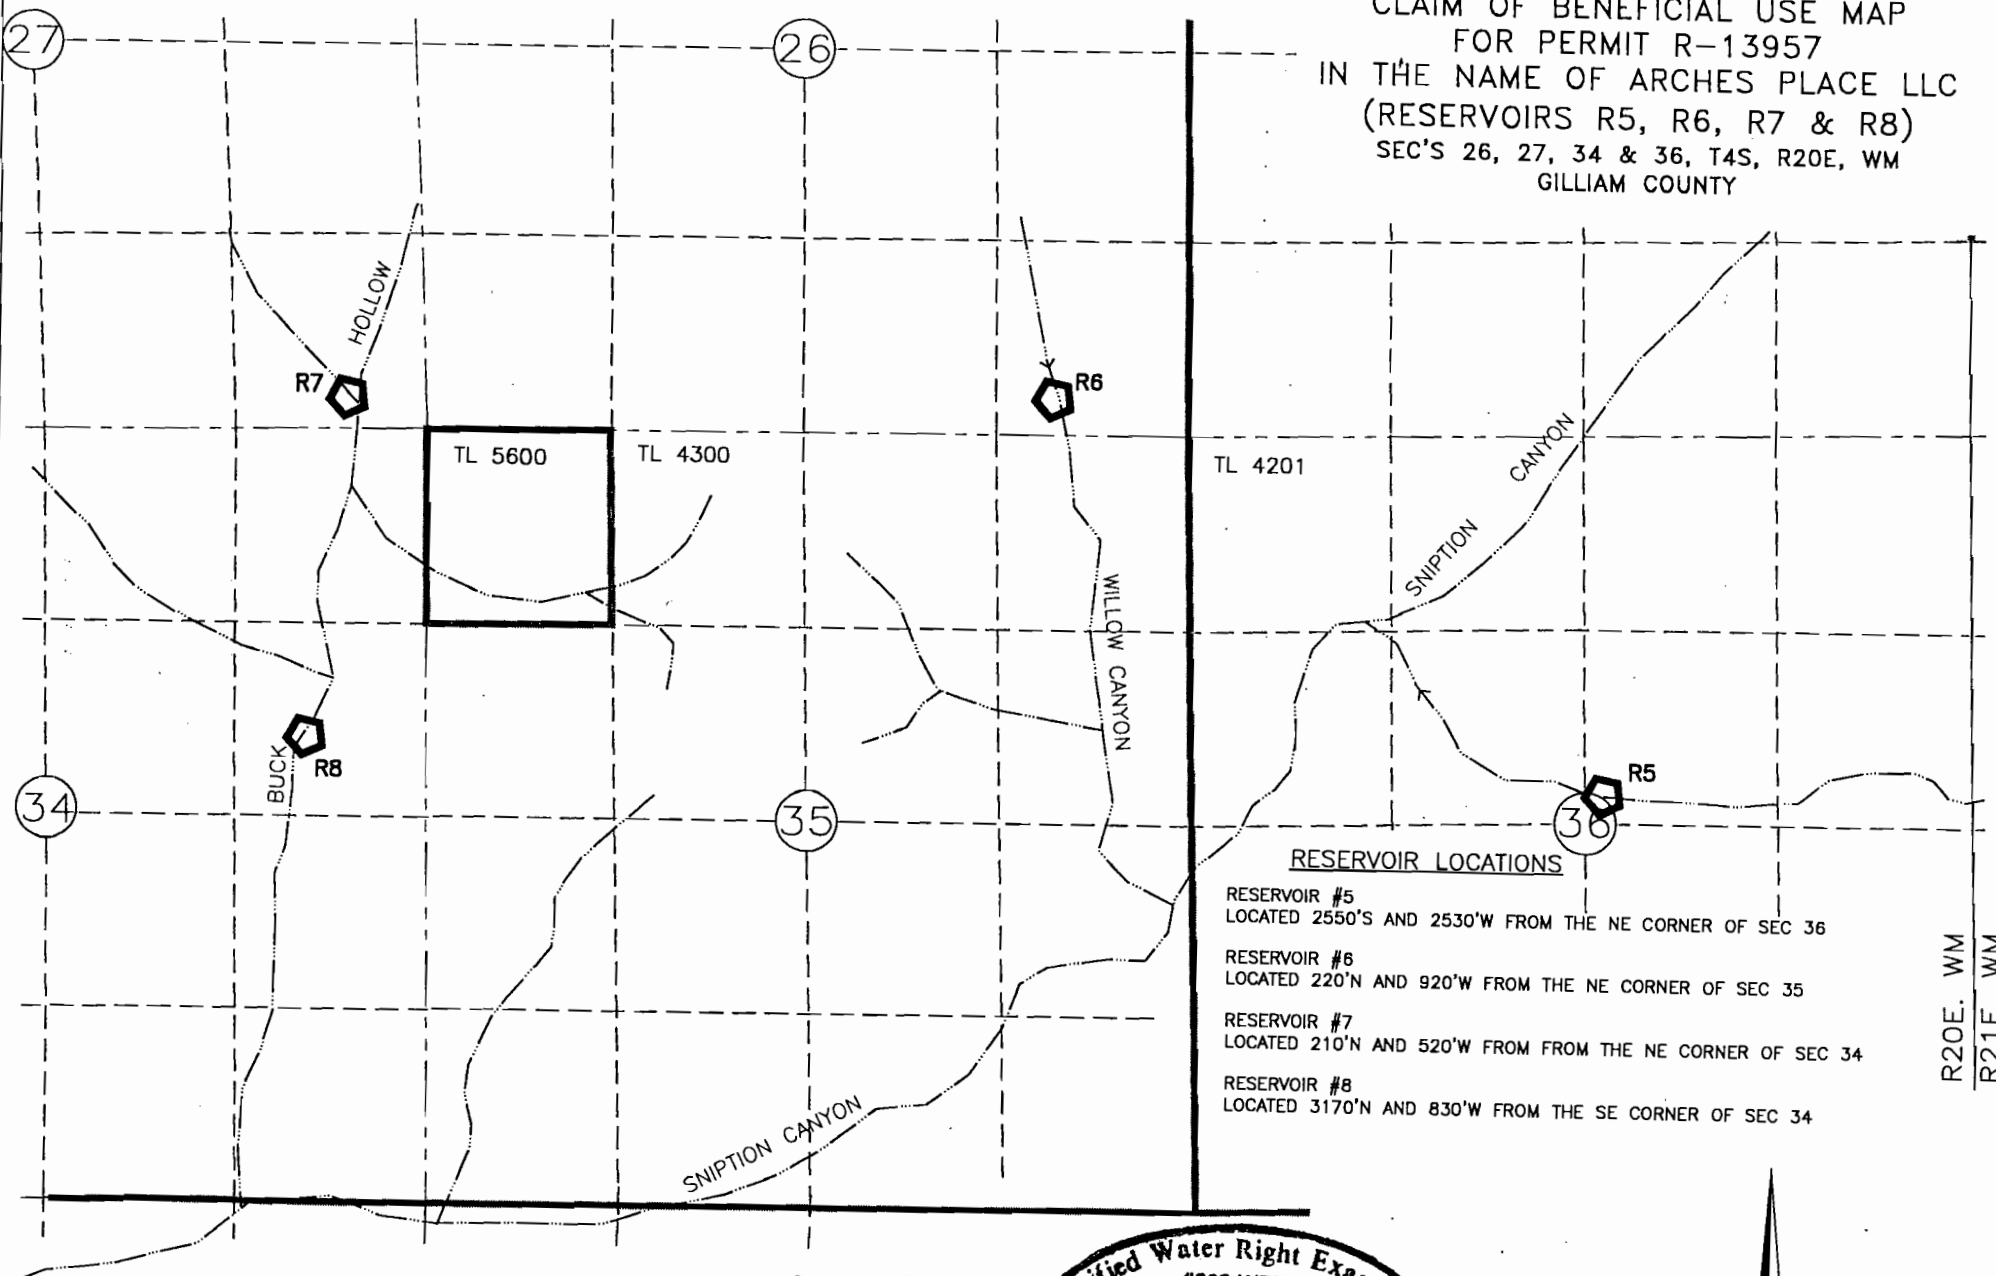

RESERVOIR LOCATIONS



- RESERVOIR #5
LOCATED 2550'S AND 2530'W FROM THE NE CORNER OF SEC 36
- RESERVOIR #6
LOCATED 220'N AND 920'W FROM THE NE CORNER OF SEC 35
- RESERVOIR #7
LOCATED 210'N AND 520'W FROM FROM THE NE CORNER OF SEC 34
- RESERVOIR #8
LOCATED 3170'N AND 830'W FROM THE SE CORNER OF SEC 34

NOTE:
THE PURPOSE OF THIS MAP IS TO IDENTIFY THE APPROXIMATE LOCATION
OF THE RESERVOIR AND STORED WATER. IT IS NOT INTENDED TO
PROVIDE INFORMATION RELATIVE TO THE LOCATION OF PROPERTY
OWNERSHIP BOUNDARY LINES.

RECEIVED

FEB 24 2009

WATER SOURCES DEPT

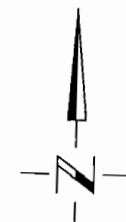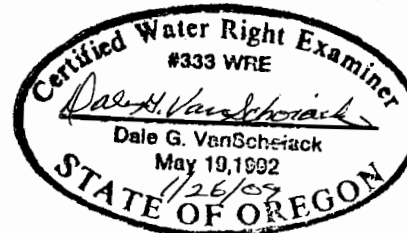

0 1320 2640

SCALE IN FEET