



CLAIM OF BENEFICIAL USE MAP
FOR PERMIT R-13956
IN THE NAME OF ARCHES PLACE LLC
(RESERVOIRS R1, R2, R3 & R4)
SEC'S 18, 19 & 30, T4S, R21E, WM
GILLIAM COUNTY

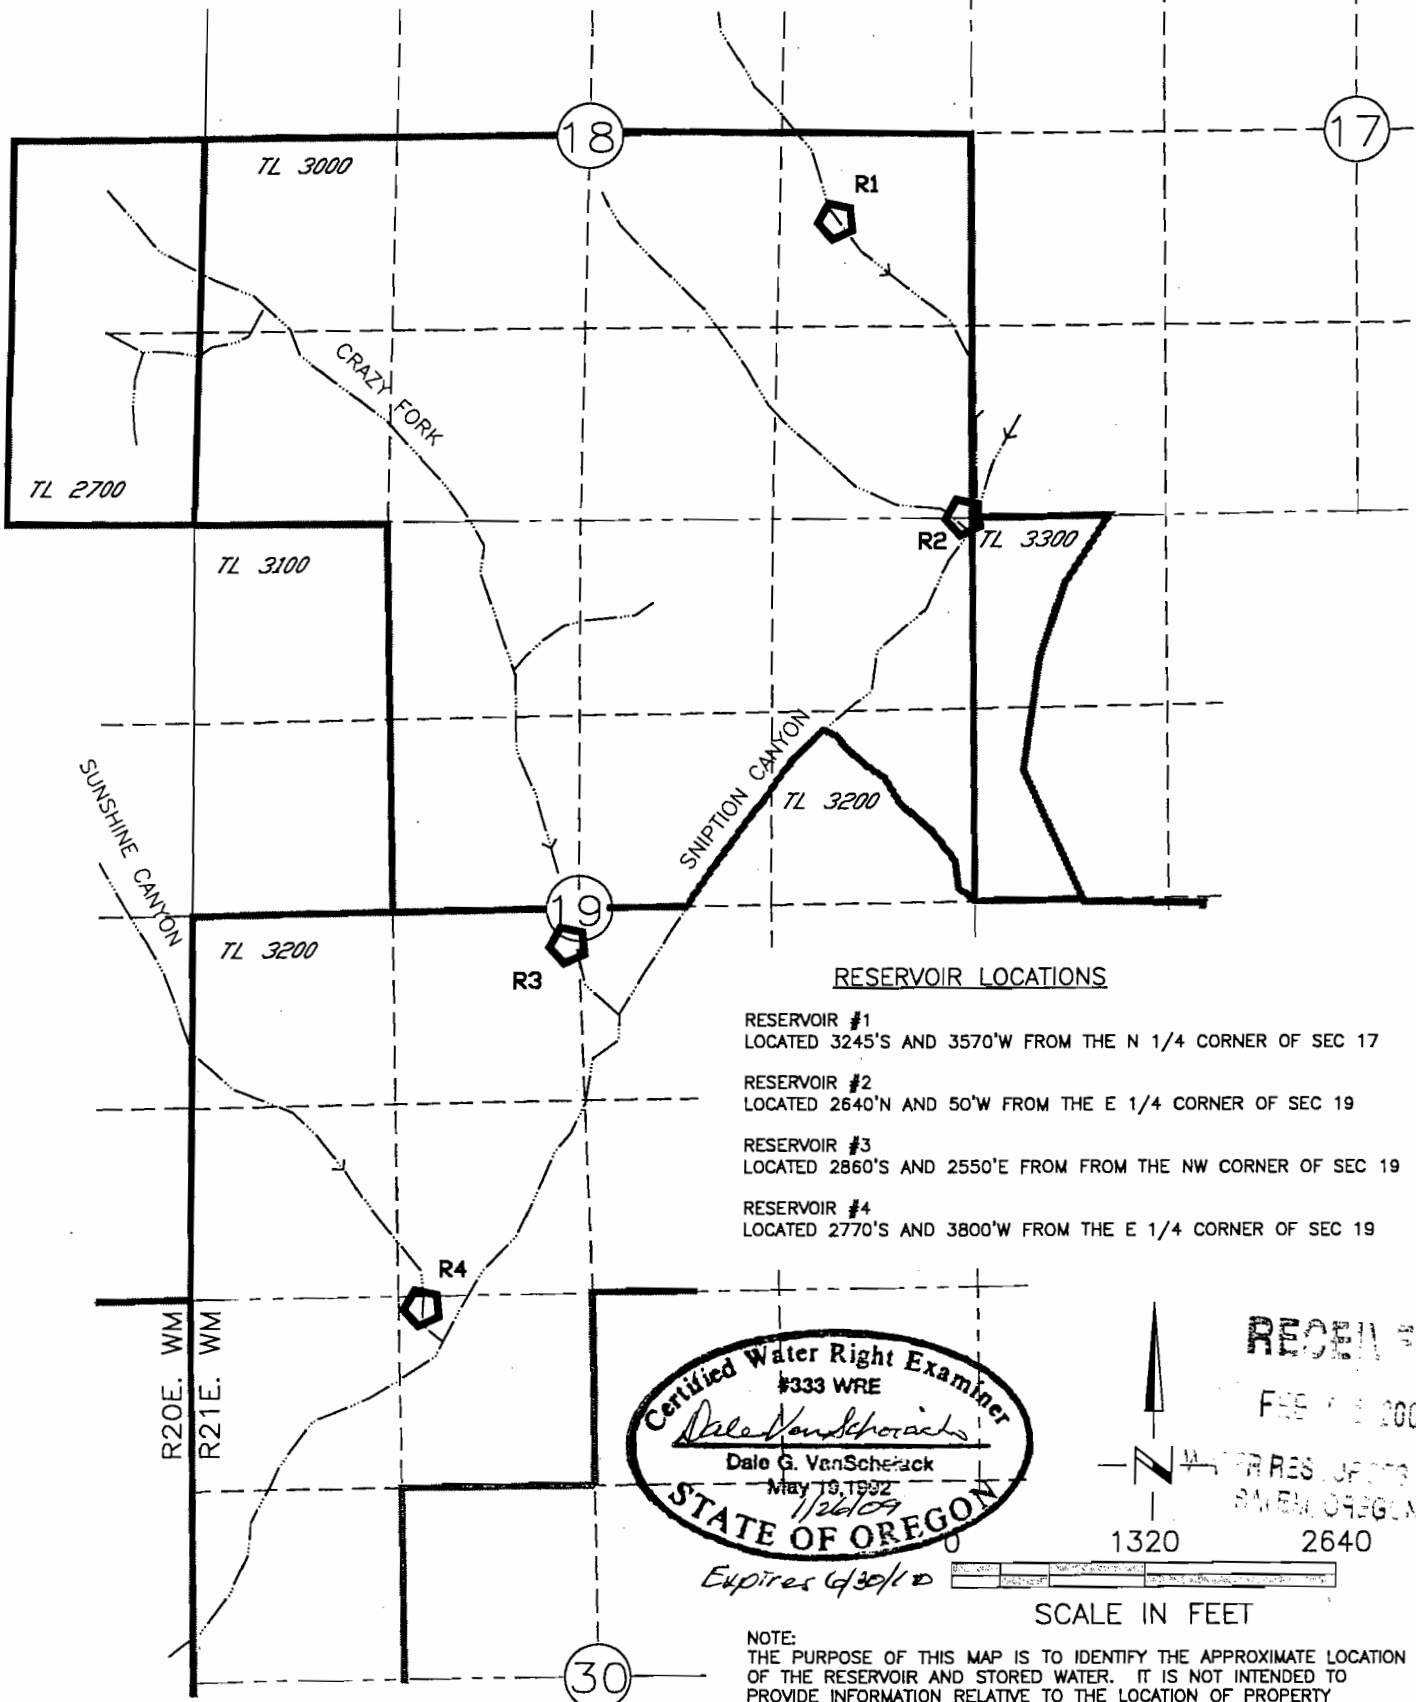


RESERVOIR LOCATIONS

- RESERVOIR #1
LOCATED 3245'S AND 3570'W FROM THE N 1/4 CORNER OF SEC 17
- RESERVOIR #2
LOCATED 2640'N AND 50'W FROM THE E 1/4 CORNER OF SEC 19
- RESERVOIR #3
LOCATED 2860'S AND 2550'E FROM FROM THE NW CORNER OF SEC 19
- RESERVOIR #4
LOCATED 2770'S AND 3800'W FROM THE E 1/4 CORNER OF SEC 19

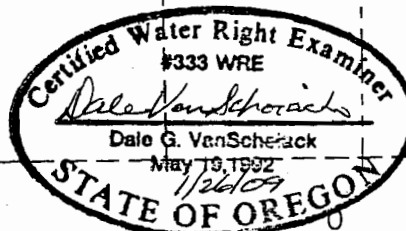

Expires 6/30/10

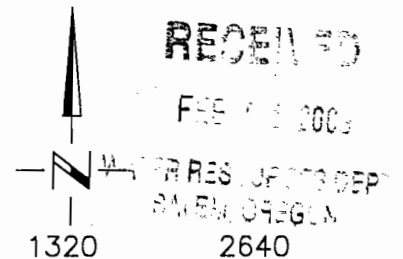

SCALE IN FEET

NOTE:
THE PURPOSE OF THIS MAP IS TO IDENTIFY THE APPROXIMATE LOCATION
OF THE RESERVOIR AND STORED WATER. IT IS NOT INTENDED TO
PROVIDE INFORMATION RELATIVE TO THE LOCATION OF PROPERTY
OWNERSHIP BOUNDARY LINES.