


Final Proof Survey for FRANK SILVA

Change in Point of Diversion

Transfer No. 10072

Township 13 South, Range 29 East, W.M.

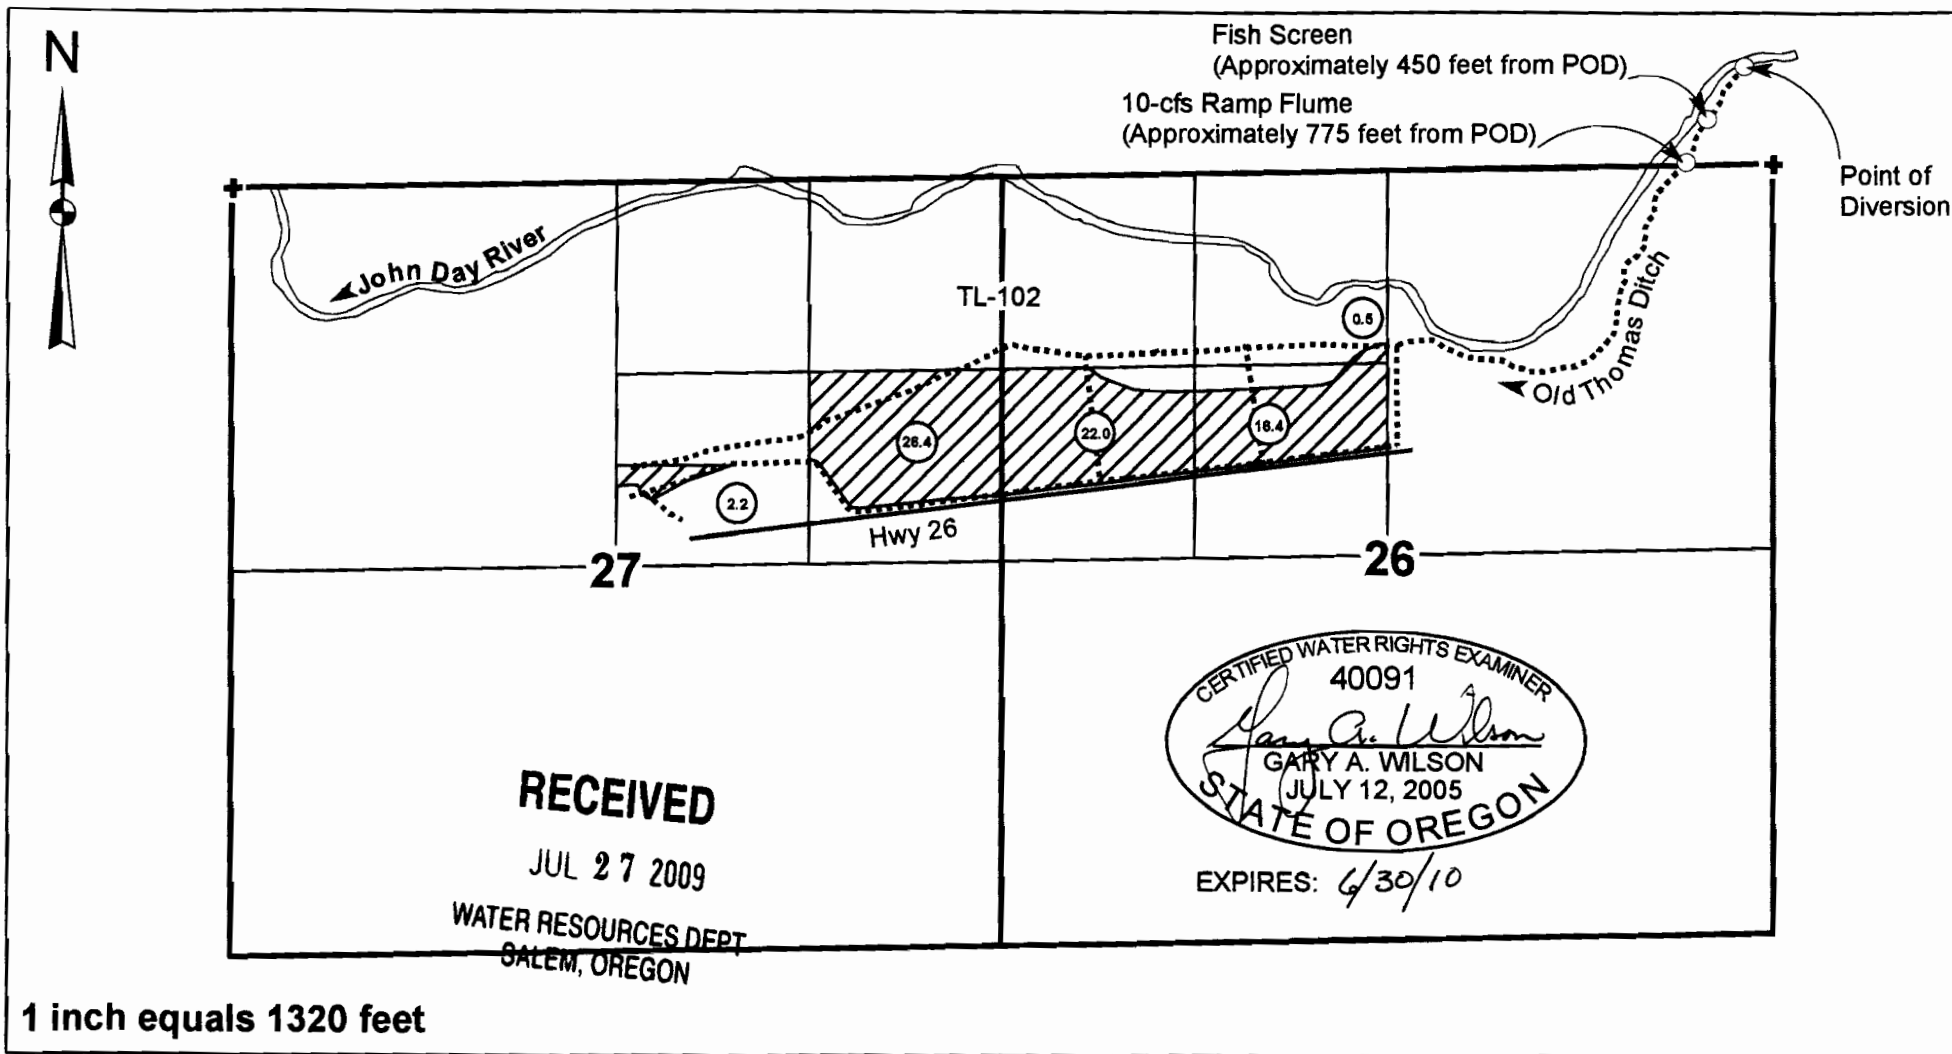

Legend

- + Located Section Corner
- Old Thomas Ditch and laterals
- ▨ Place of Use

Point of Diversion:
200 feet West and 680 feet North from
NE ¼ Corner Section 26
(N 44.4194° W 119.18559°)
Old Thomas Ditch

This map is not intended to provide legal dimensions or location of property ownership lines.