


# T.34S.R.IW.W.M.

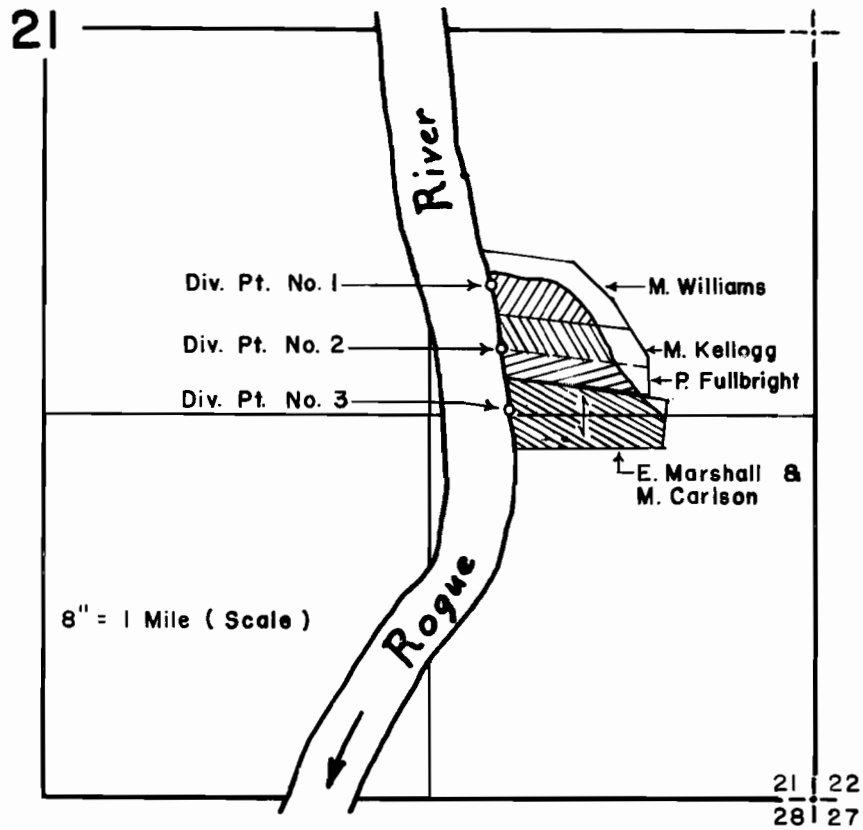

Div. No. 1 is located 1765' N. & 1105' W. from S.E. Cor. Sec. 21  
 Div. No. 2 is located 1550' N. & 1070' W. from S.E. Cor. Sec. 21  
 Div. No. 3 is located 1335' N. & 1045' W. from S.E. Cor. Sec. 21

## FINAL PROOF SURVEY UNDER

Transfer No. K-38

Application No. \_\_\_\_\_ Permit No. \_\_\_\_\_  
 IN NAME OF

**MARTIN E. KELLOGG, et al**

Surveyed Aug. 28, 1968, by D.C. Hendrix