


THIS MAP WAS PREPARED FOR THE PURPOSE OF IDENTIFYING THE LOCATION OF THE WATER RIGHT AND IS NOT INTENDED TO PROVIDE LEGAL DIMENSIONS OR LOCATIONS OF PROPERTY OWNERSHIP LINES.

WRD 7-21-2009
706

T34S; R7E 7.5E

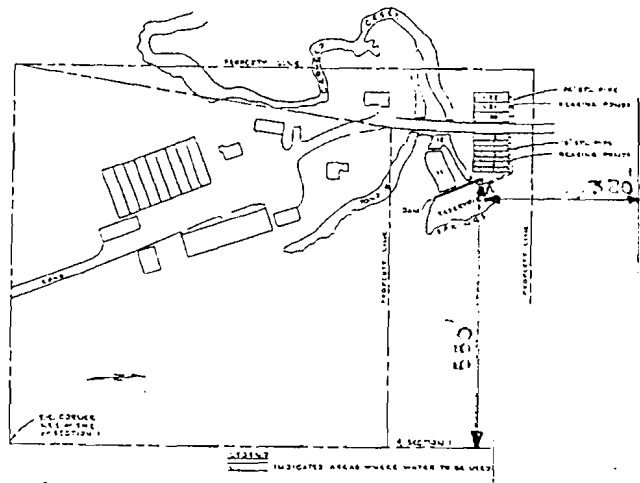

SCALE: 1" = 400'

FINAL PROOF SURVEY
UNDER
APPLICATION NO. 5-80549 PERMIT NO. 53418
IN NAME OF
OREGON DEPARTMENT OF FISH AND WILDLIFE
SURVEYED: 8/3/98 BY: DODGE