

TOWNSHIP 15 SOUTH, RANGE 5 WEST, W.M.



AREA OF AUTHORIZED USE PER APPLICATION #44681 &
42470, PERMIT #33500 & 51765



AREA OF PERMIT 81858 CONTRACT 5-07-10-W1065





AREA OF FINAL PROOF SURVEY

EXISTING POINTS OF DIVERSIONS:

4090 FT SOUTH 1090 FEET WEST, 8450 FEET SOUTH AND 8440 FEET
WEST, 1890 FEET SOUTH AND 8270 FEET WEST, ALL FROM N 1/4 CORNER,
SECTION 10.


POINT OF DIVERSION:

4200 FEET SOUTH AND 1170 FEET WEST OF THE N 1/4 CORNER
OF SECTION 10.

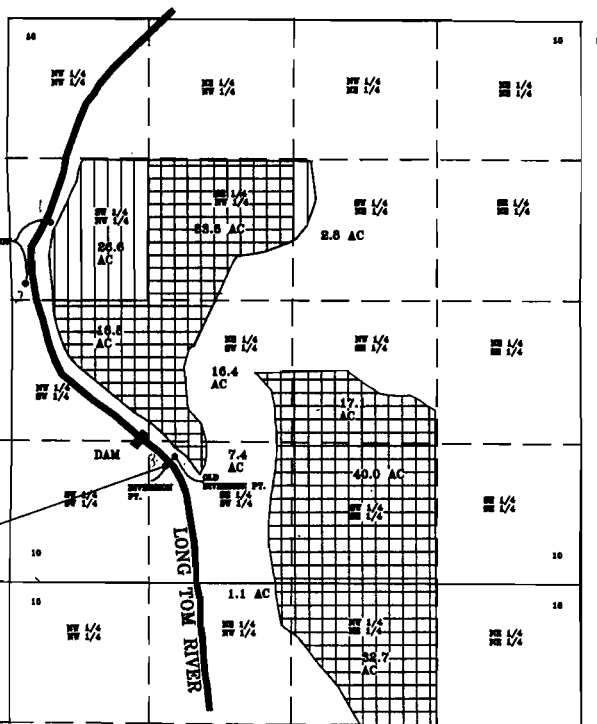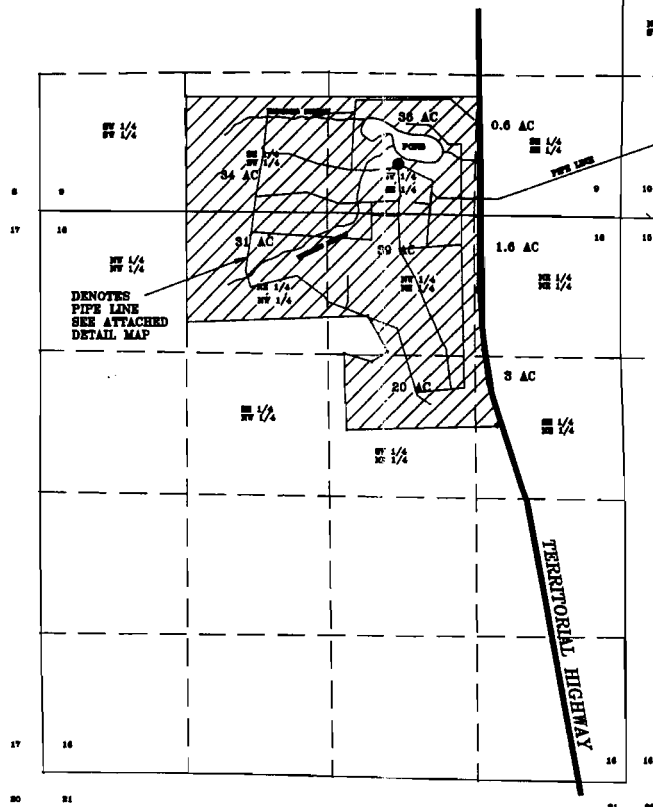

SCALE 1" = 1320'

FINAL PROOF SURVEY
FOR
JEFF DOYLE
96040 TERRITORIAL HWY
MONROE, OREGON 97456
PH (541) 998-9707
BY
FORD-NESS-FASSBENDER, INC.
PO BOX 22735
EUGENE, OR 97402
PH (541) 344-1852
MAY 22, 1998

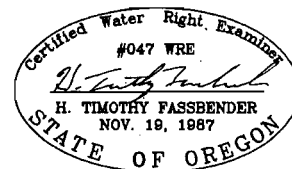

NOTES:
THIS MAP WAS PREPARED FOR THE
PURPOSE OF IDENTIFYING THE LOCATION
OF THE WATER RIGHT ONLY. IT IS NOT
INTENDED TO PROVIDE INFORMATION
ON LOCATION OF PROPERTY OR OTHERWISE ADVERSE.

ACAD. NO. 807149
FOR NO. 1854