


RECEIVED

AUG 28 1998

WATER RESOURCES DEPT.
SALEM, OREGON

T 22 S, R 32 E, WM

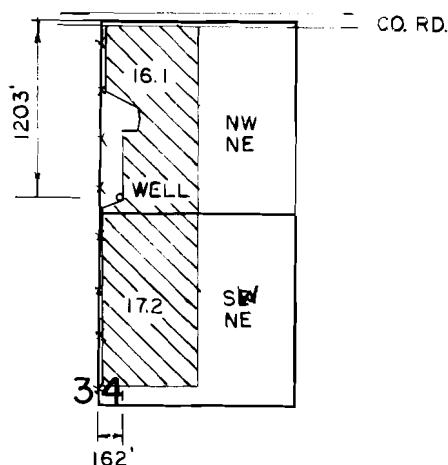

THE PURPOSE OF THIS MAP IS TO
DEFINE THE LOCATION OF THE
WELL. THIS MAP IS NOT INTENDED
TO BE USED FOR ANY OTHER
PURPOSE.

FINAL PROOF SURVEY

UNDER
APPLICATION NO. G-13702
PERMIT NO. G-12067

IN THE NAME OF
ROBERT M. & STEPHANIE J.
HOWES

Scale: 4 = 1 MILE

Date: AUG. 1998

Job: 1511A

Dsn:

Drn: CHRIS


Ckd:



M. A. PALMER & SONS, INC.
ENGINEERING & SURVEYING
254 N. Alder - Box 61
Burns, Oregon 97720

Sht. No.

of 1

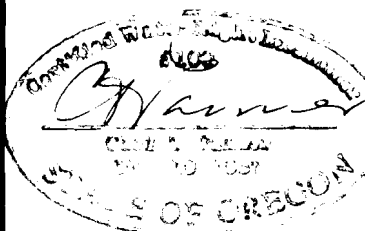

RENEW 1-1-1999