

D-41-4

# FINAL PROOF SURVEY


RECEIVED

UNDER  
APPLICATION NO. G-12400 PERMIT NO. G-11500  
IN THE NAME OF

WILLIAM K. ARMSTRONG  
555 ROBERTA AVENUE  
LAKEVIEW, OREGON 97630



SCALE: 1"=1320'

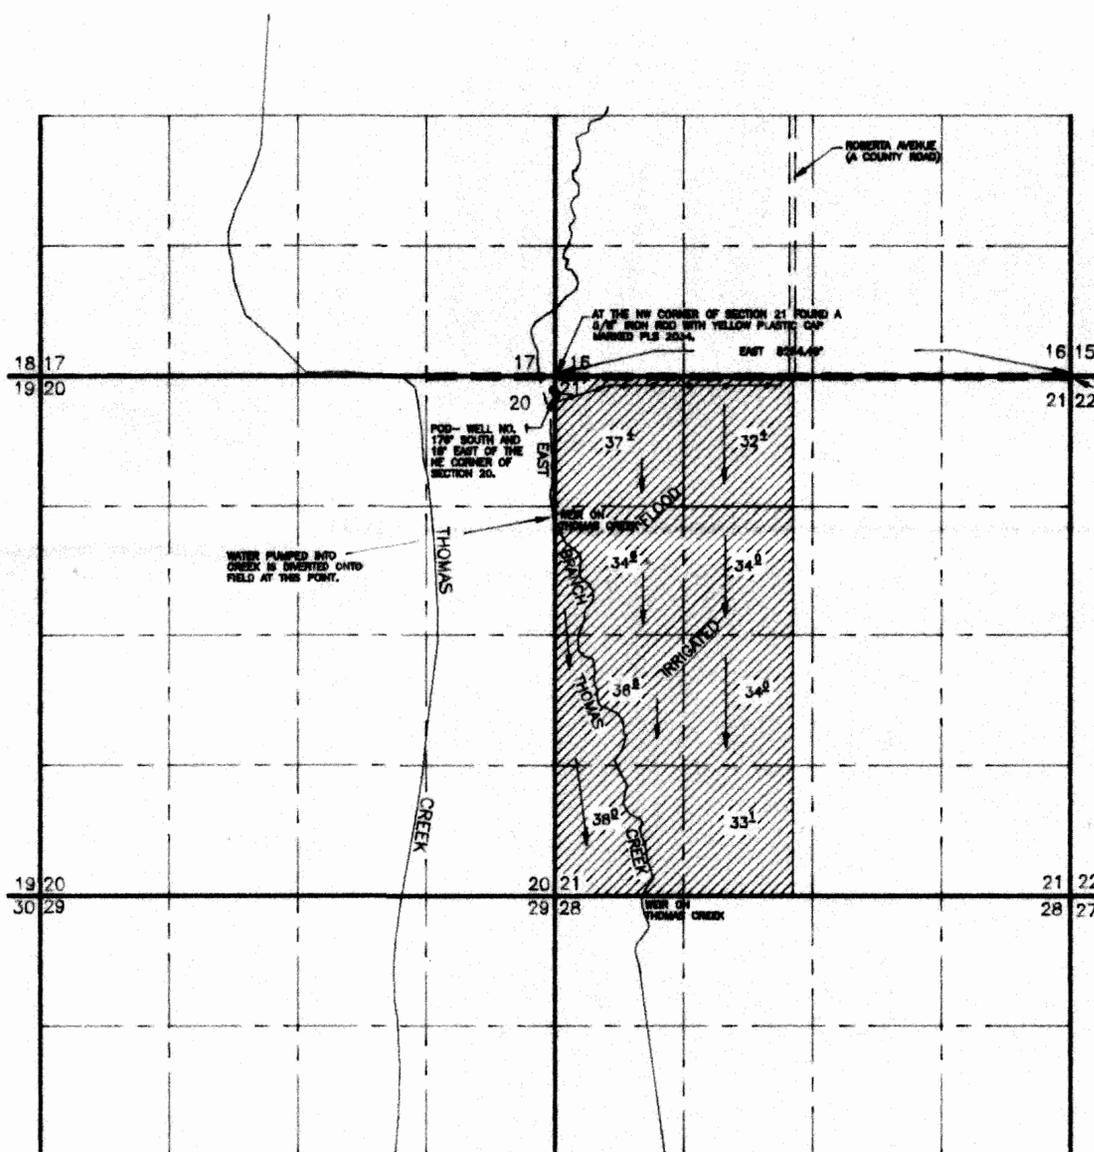

T 39 S

R 20 E

### LEGEND



AREA IRRIGATED UNDER THIS APPLICATION  
SUPPLEMENTAL TO CERTIFICATE # 27023.  
TOTAL IRRIGATED AREA: 280.1 ACRES



DIRECTION OF FLOW



SECTION LINE




COUNTY ROAD



BURIED MAIN LINE WITH RISERS

NOTE: PREPARATION OF THIS MAP IS FOR IDENTIFYING PROPOSED  
WATER RIGHTS ONLY. IT HAS NO INTENT TO PROVIDE LOCATIONS  
OR DIMENSIONS OF PROPERTY BOUNDARIES..

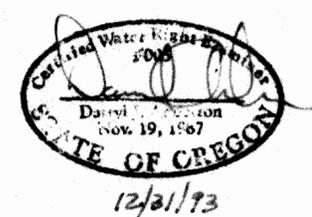

PREPARED FOR:  
WILLIAM K. ARMSTRONG  
555 ROBERTA AVENUE  
LAKEVIEW, OREGON 97630

PREPARED BY:  
ANDERSON ENGINEERING AND SURVEYING  
618 SOUTH FIRST STREET  
P.O. BOX 28  
LAKEVIEW, OREGON 97630  
(503) 947-4407 FAX 947-2321

AUGUST 19, 1993 SHEET 1 OF 1