


RECEIVED


SEP 30 1993

WATER RESOURCES DEPT
SALEM, OREGON

TOWNSHIPS 4 & 5 SOUTH, RANGE 1 WEST, W.M.

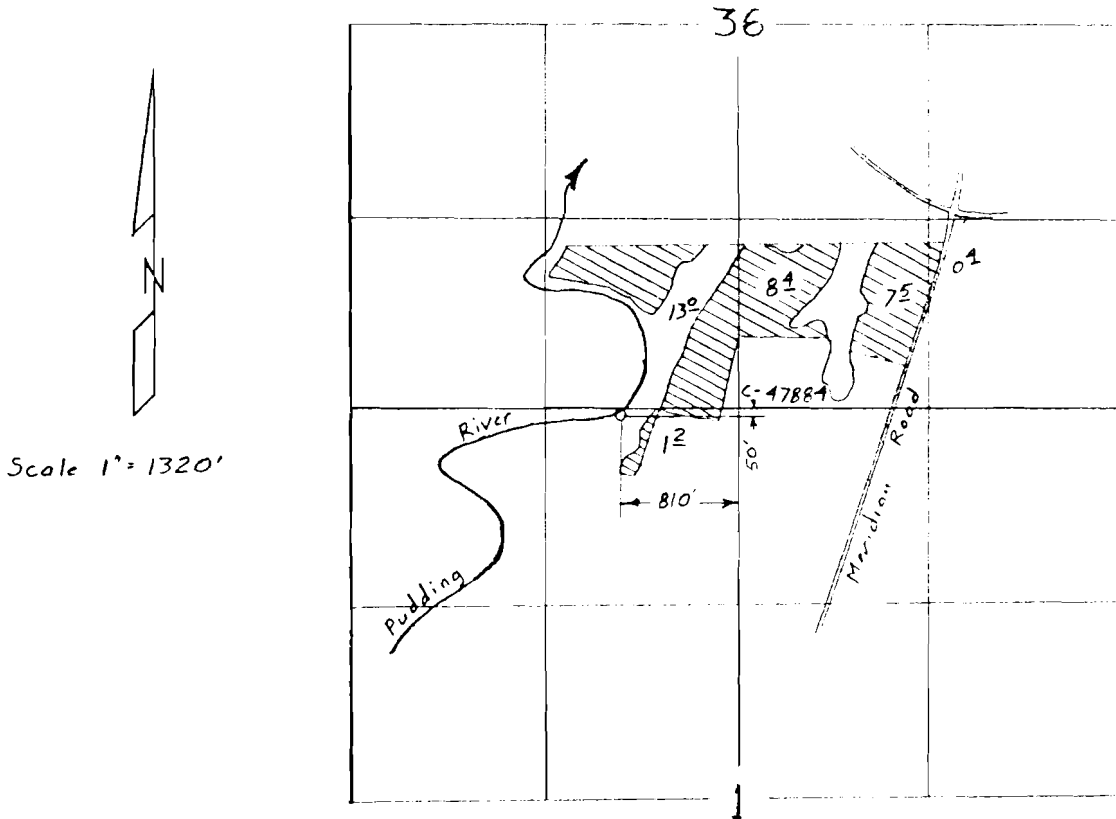

FINAL PROOF MAP
for
IVAN SNEGIREV

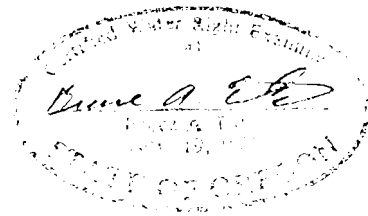

Application 70153 Permit 50875

This map is for the purpose of locating a water right only and has no intent to provide the location of property lines or legal dimensions.