


T. 22 S., R. 5 W., W. M.

SECTION 23

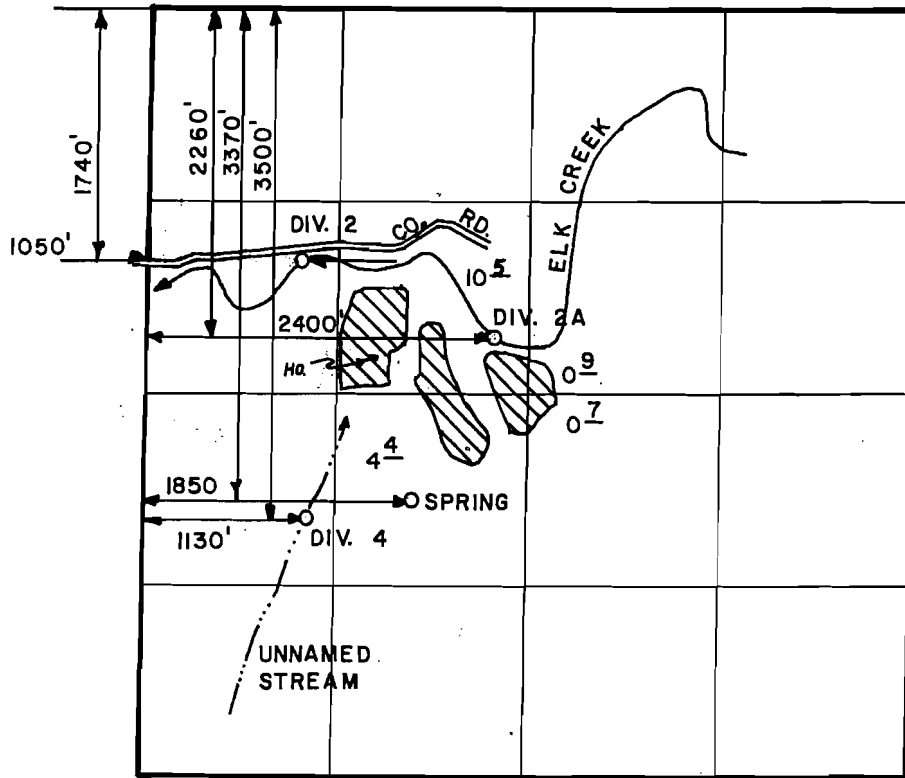

SCALE: 4" = 1 MILE

FINAL PROOF SURVEY
UNDER

Application No. 57584 Permit No. 44335.....
IN NAME OF

MARTIN A. THOMPSON

Surveyed OCT. 23... 1986., by J. M. SCHMORDE