


T. 6S. R. 2W. W.M.

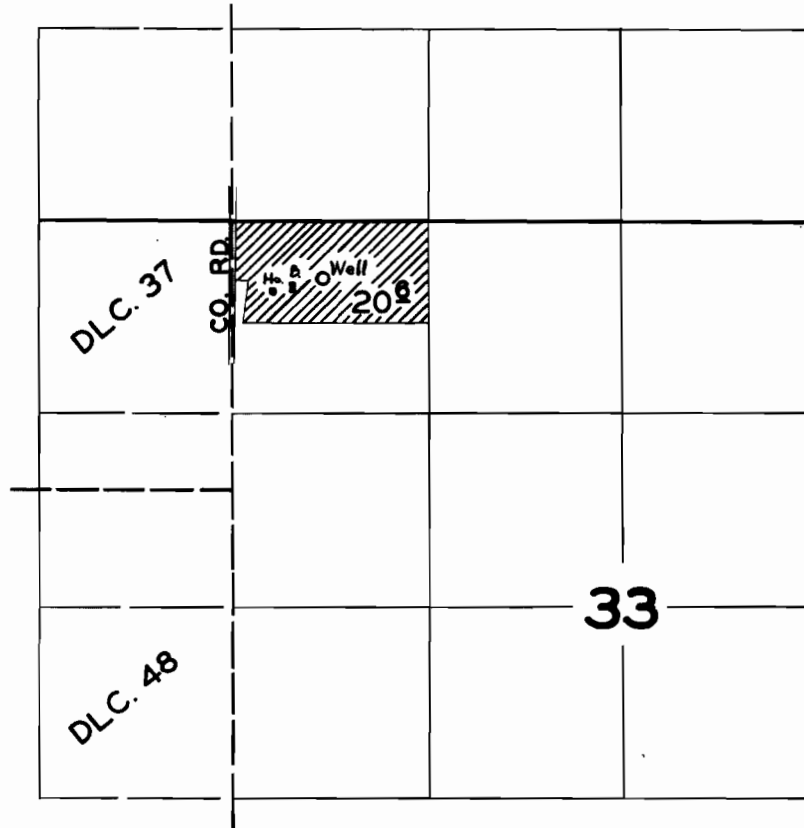

**FINAL PROOF SURVEY**

UNDER

Application No. G-149 Permit No. G-55

IN NAME OF

HERMAN C. WACKEN

Surveyed MAR. 22, 1957, by C. O. BARTELS