

FINAL PROOF SURVEY

UNDER

APPLICATION #G-12110 PERMIT #G-11122
SITUATED IN SW 1/4 SE 1/4 OF SECTION 19,
AND THE W 1/2 NE 1/4 OF SECTION 30, T38S,
R11EWM, KLAMATH COUNTY, OREGON

AUGUST 1993

MAP PREPARED FOR
-- WALT & NANCY HAMMERICK --

MAP PREPARED FROM
-- FIELD SURVEY --


LOCATION OF WELL
BY FIELD INSPECTION

230 FEET NORTH AND 440 FEET EAST OF THE
1/4 CORNER COMMON TO SECTIONS 19 AND 30

LOCATION OF THE 1/4 COMMON TO SECTIONS 19
AND 30 WAS DETERMINED BY $\frac{1}{4}$ OF HASKINS ROAD
AND FENCE LINES TO THE WEST.

TOTAL ACREAGE

-- 34.0 Ac. --

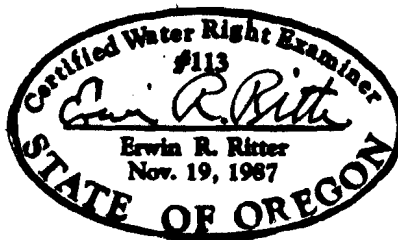

THE PURPOSE OF THIS MAP IS TO IDENTIFY THE
LOCATION OF THE WATER RIGHT. IT IS NOT INTENDED TO
PROVIDE INFORMATION RELATIVE TO THE LOCATION OF
PROPERTY OWNERSHIP BOUNDARY LINES.

TRU-LINE SURVEYING
2333 SUMMERS LANE
KLAMATH FALLS, OR. 97603

