



T. 2N., R. 30E., W.M.

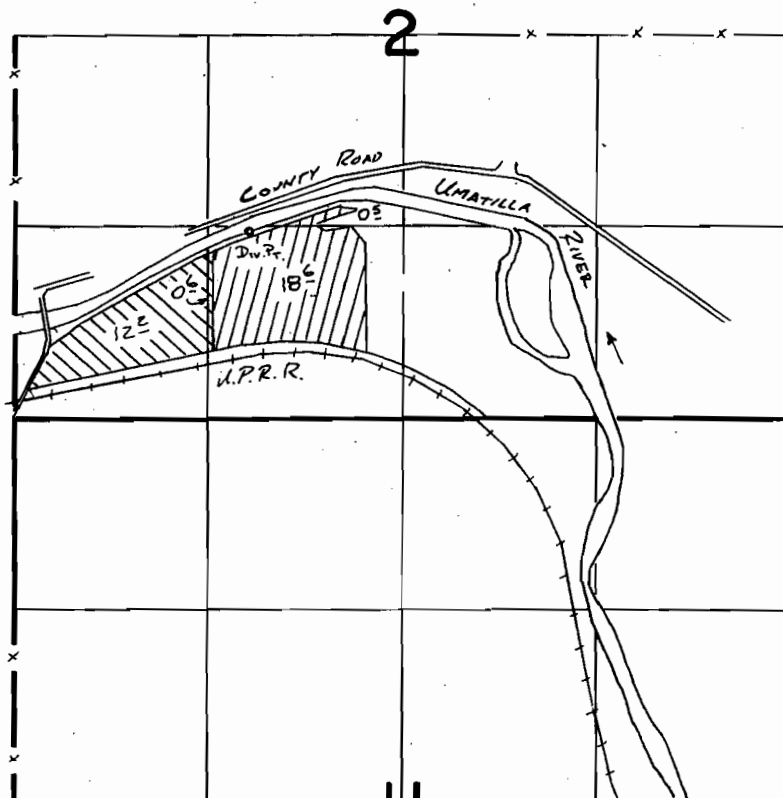

D.W.P. Loc: 1300 N. & 1050 W. FROM S<sup>1</sup>/<sub>4</sub> COR. SEC. 2

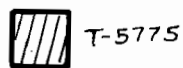

**FINAL PROOF SURVEY**  
UNDER

**TRANSFERS 5775, 5776**  
IN NAME OF

.....**BILL ANDERSON**.....

Surveyed ...11.3..... 1988, by *V.H. Church*.....

SCALE 1" = 1320'