


T. 2N., R. 30E., W.M.

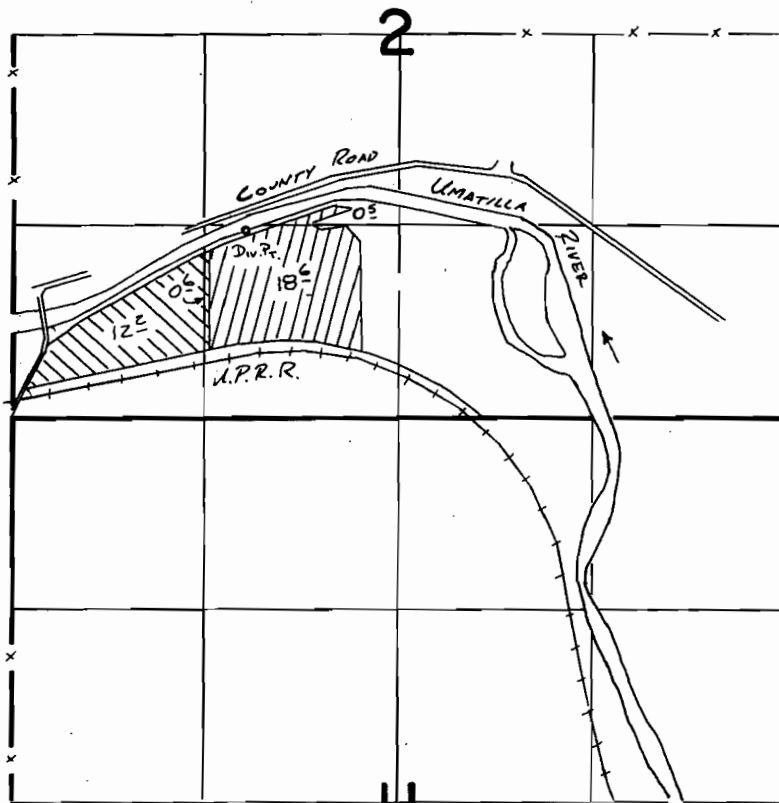

SCALE 1" = 1320'

D.W.P. Loc: 1300N. & 1050W. FROM SW4 COR. SEC. 2



T-5776



T-5775

**FINAL PROOF SURVEY**  
UNDER

**TRANSFERS 5775, 5776**  
IN NAME OF

.....**BILL ANDERSON**.....

Surveyed ...11.3... 1988, by *V.H. Church*.....