

CLAIM OF BENEFICIAL USE MAP


T-8028

FOR


JACK L. AND E. KATHERINE GILLETTE

SURVEYED 6/13/2001

LOCATED IN THE S1/2 OF SECTION 7
TOWNSHIP 27 SOUTH, RANGE 18 EAST, W.M.,
LAKE COUNTY, OREGON

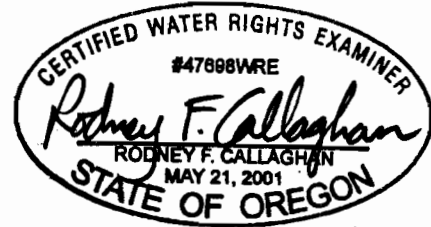

RE-NEW: 12/31/01

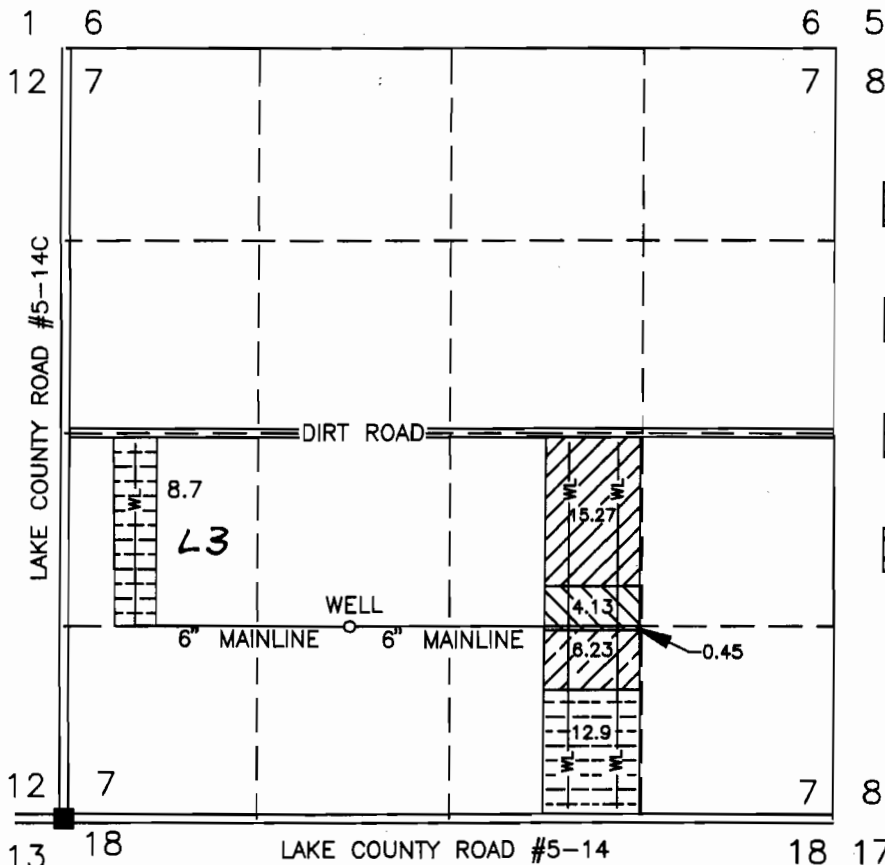

ACRES TRANSFERRED

-  21.6 ACRES OF WATER RIGHTS UNDER PERMIT #G-6261
-  6.23 ACRES OF WATER RIGHTS UNDER PERMIT #G-9311
-  4.58 ACRES OF WATER RIGHTS UNDER PERMIT #G-7191
-  15.27 ACRES OF WATER RIGHTS UNDER PERMIT #G-1224

RECEIVED

SEP 04 2001

WATER RESOURCES DEPT.
SALEM, OREGON

FOUND 5/8" IRON ROD AS PER
CORNER FORM ON FILE IN THE
LAKE COUNTY SURVEYOR'S OFFICE.

P.O.A. LOCATED NORTH 1320 FEET
AND EAST 1958 FEET FROM THE
SOUTHWEST CORNER OF SECTION 7.

THIS MAP IS FOR THE PURPOSE OF LOCATING A
WATER RIGHT ONLY AND HAS NO INTENT TO PROVIDE
LEGAL DIMENSIONS OR THE LOCATION OF
PROPERTY LINES.

LEGEND

-  FOUND LAND SURVEY MONUMENT AS NOTED.
-  WHEEL LINE
(SEE SITE REPORT FOR
SIZE AND NUMBER OF
SPRINKLER HEADS)



SCALE 1"=1320'

PREPARED FOR: JACK L. AND E. KATHERINE GILLETTE
P.O. BOX 556
CHRISTMAS VALLEY, OR 97641

PREPARED BY:

CLS

CALLAGHAN LAND SURVEYING
427 SOUTH H STREET
LAKEVIEW, OR 97630
(541) 947-5841

DATE: 8/21/01

DRAWING: 200133

Gov lot number added to map by WRD staff 10-1-2009 JC