


T23S. R.31E. W.M.

Prather Creek

T.23S. R.31E.  
T.23S. R.32E.

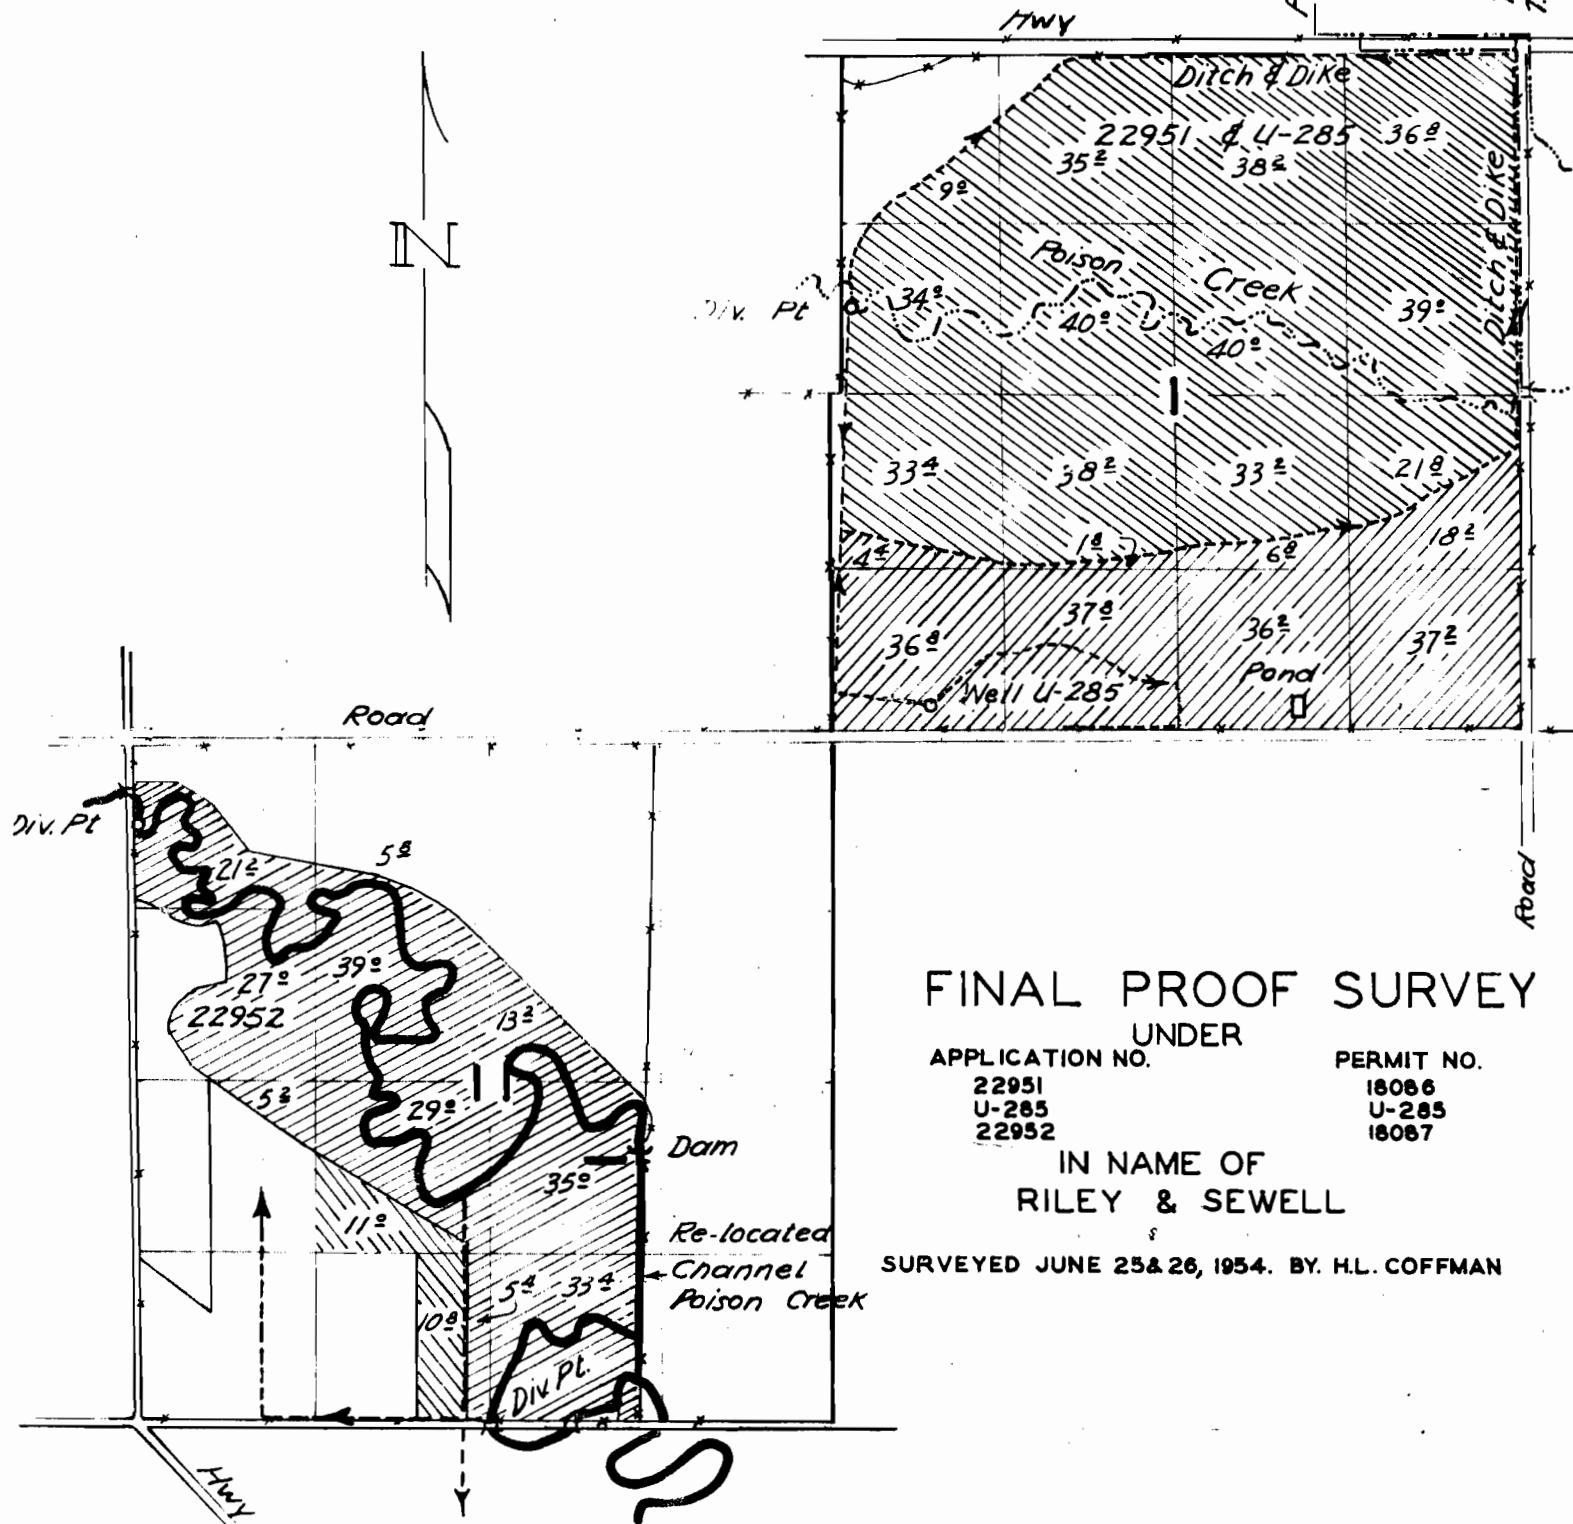

FINAL PROOF SURVEY

UNDER

APPLICATION NO.

PERMIT NO.

22951  
U-285  
22952

18066  
U-285  
18067

IN NAME OF  
RILEY & SEWELL

SURVEYED JUNE 25 & 26, 1954. BY H.L. COFFMAN