


# T.6S., R.1W., W.M.

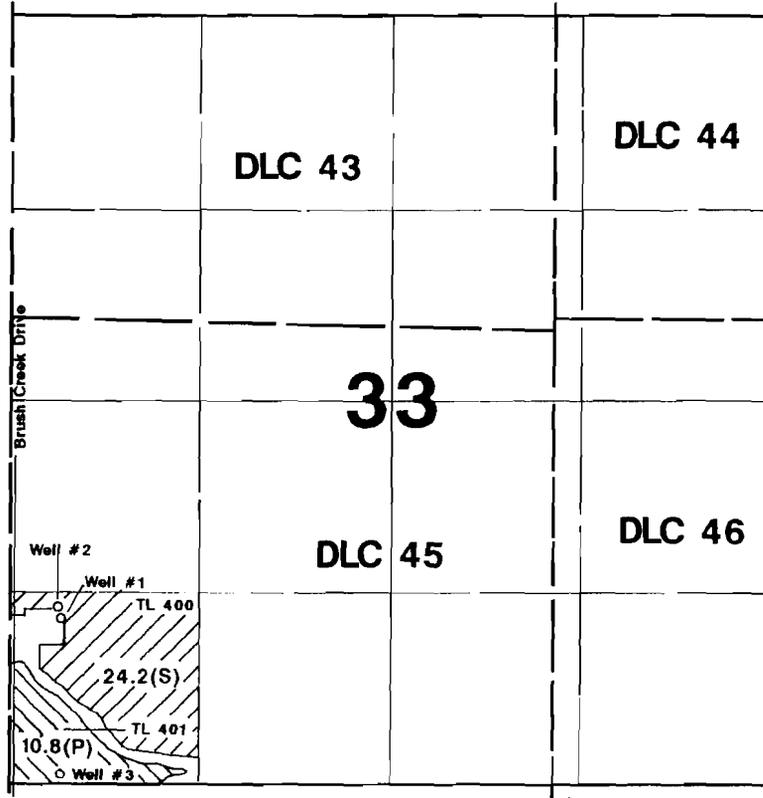

1" = 1320'



Remains with Wells #1-2



Transfer to Well #3 (New POA)

Well #1 is located 1120' N & 360' E  
 Well #2 is located 1180' N & 350' E  
 Well #3 (new POA) is located 20' N & 355' E ---all from the SW corner of Section 33.

## Application Map


**RECEIVED David & Rebecca Campbell**

MAR 12 2008

WATER RESOURCES DEPT  
 SALEM, OREGON

Transfer #:

This Map was Prepared for the Purpose of Identifying the Location of a Water Right Only and is Not Intended to Provide Legal Dimensions or Location of Property Ownership Lines.

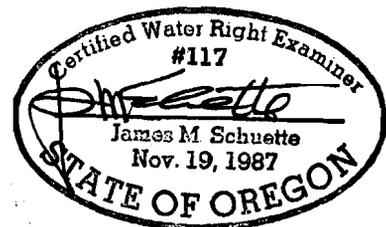

T 10558