

RECEIVED

N. LINE LOT 6, SEC 5

SEP - 8 1997

WATER RESOURCES DEPT.  
SALEM, OREGON



1" = 100'

IN THE SW 1/4,  
NW 1/4 SEC 5,  
T3S, R45E, WM

MAP BASED ON  
WALLOWA COUNTY  
ASSESSOR MAP  
#3S 4S 5 BC

N 114° 3' E 1182'

WEST 1/4 COR.  
SEC 5, T3S,  
R45E.

EDGEWATER ROAD

TL103

TL100

HOUSE

1" STEEL PIPE

275'

TL300


1/3 HP  
SUBMERSIBLE  
PUMP

PUMP IS 1103' N &  
1550' E OF W 1/4  
COR. SEC 5.

MEAN HIGH WATER LEVEL OF LAKE  
CONTROLLED BY DAM ERECTED IN 1916

DIVERSION IS LOCATED ON THE NW CORNER OF WALLOWA  
LAKE, ON THE WALLOWA RIVER, A TRIBUTARY OF THE  
GRANDE RONDE RIVER. IT WILL UTILIZE WATER  
STORED BEHIND WALLOWA LAKE DAM.

THIS MAP IS PREPARED FOR WATER  
RIGHT PURPOSES ONLY AND SHOULD NOT  
BE USED FOR PROPERTY LOCATION  
PURPOSES.

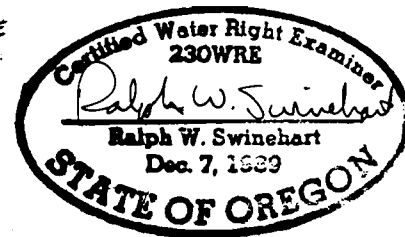

**DOMESTIC WATER RIGHT  
FINAL PROOF MAP**

IN SECTION 5, T3S, R45E, WM WALLOWA COUNTY  
PERMIT 52453 FOR: LORRAINE WAGNER

DATE  
8/97  
JOB  
93545  
DESIGN  
RWS  
DRAWN  
TCB

WALLOWA MOUNTAIN  
ENGINEERING

PO BOX 266  
ENTERPRISE, OREGON 97828  
426-9085

REVISIONS

SHEET  
OF