



T. 38 S R 8 W

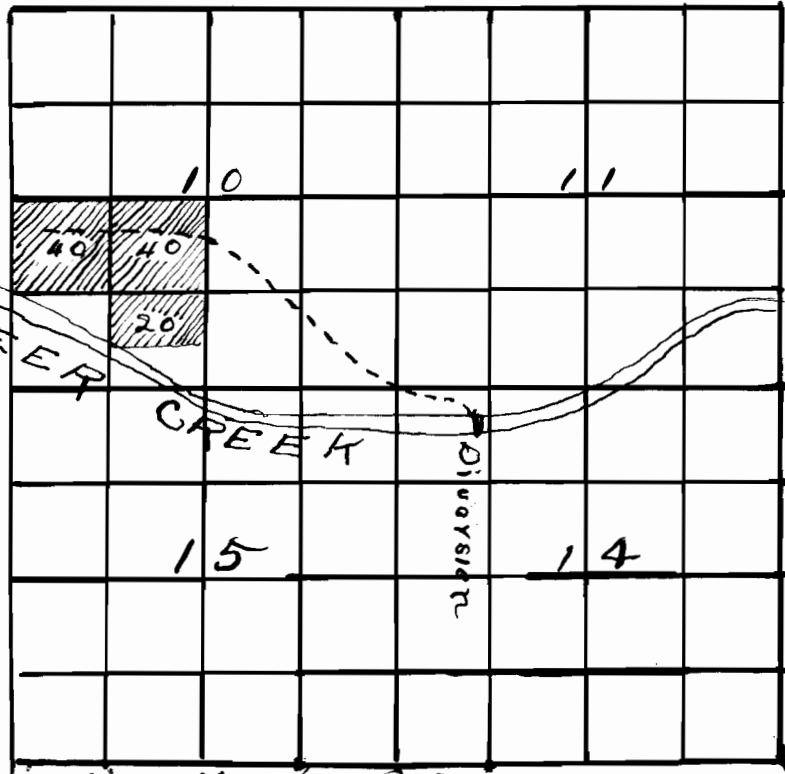

Application No. 6480  
Permit No. 4255

T.38S.R.8W.W.M.

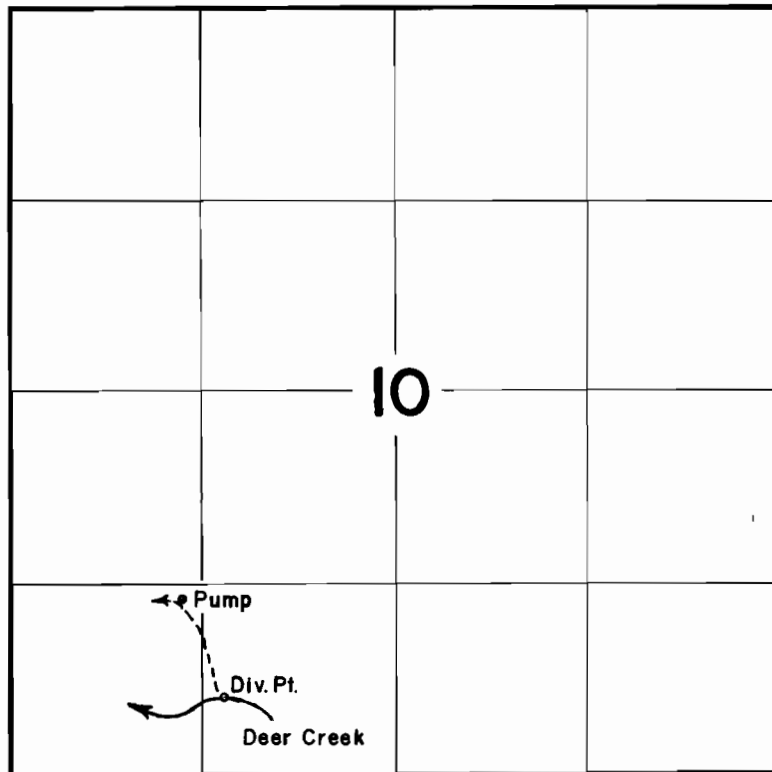

**FINAL PROOF SURVEY**  
UNDER

Transfer No. B-113  
Application No. .... Permit No. ....  
IN NAME OF

..... **Benson J. Benjamin** .....

Surveyed April 17, 1961, by C.O. Bartels.....