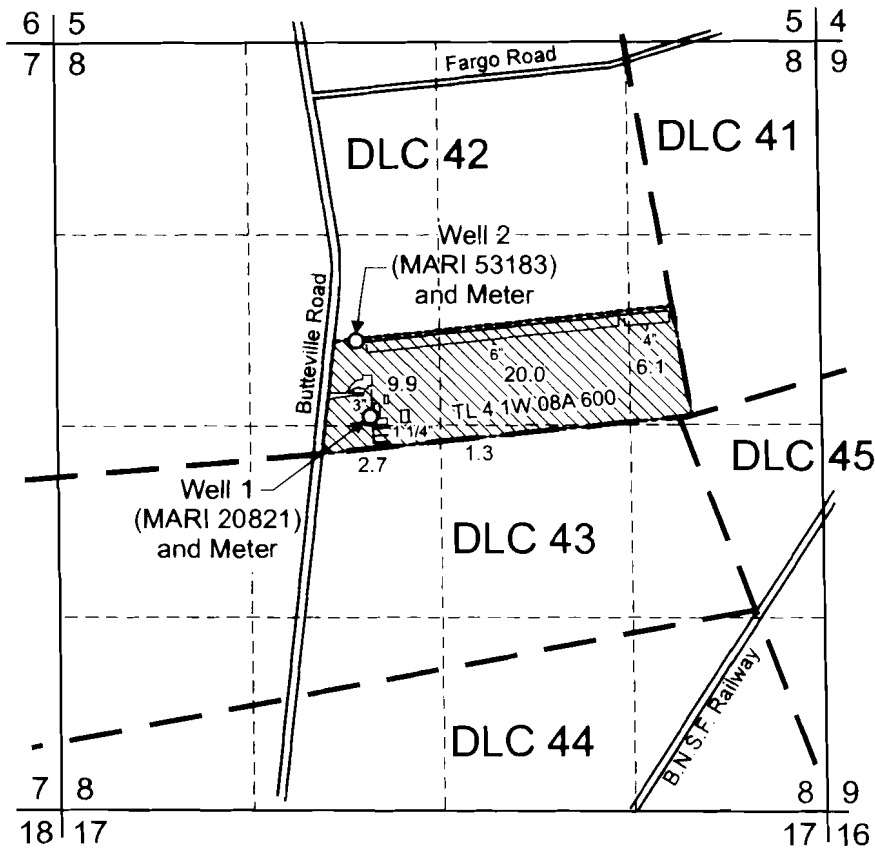
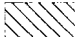

 
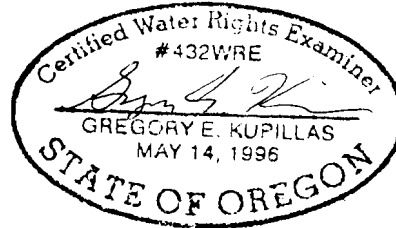


# T.4S. R.1W. Section 8, W.M.



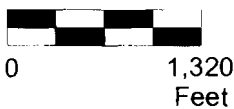
Well 1 (MARI 20821) is located 70 feet north and 2,130 feet east from the W 1/4 corner, Section 8.  
 Well 2 (MARI 53183) is located 590 feet north and 2,030 feet east from the W 1/4 corner, Section 8.

-  Area (40.0 Acres) irrigated under Transfer 8988.
-  Tax lot boundary
-  6" Irrigation main line



EXPIRATION DATE: 6/30/2011

Scale: 1" = 1,320'



This map was prepared for the purpose of identifying the location of a water right only and is not intended to provide legal dimensions or location of property ownership lines.

**Claim of Beneficial Use Map  
 Transfer 8988**

F. John Rissberger  
 T4S, R1W, Section 8, W.M.

Pacific Hydro-Geology Inc.

9/2009