

20 21

29 28



Webb Lane

DLC 53

DLC 52

DLC 50

DLC 68

Tax Lot 407 Tax Lot 406

Tax Lot 405

Tax Lot 400

Tax Lot 409

Tax Lot 408

Taylor Reservoir #1

POD #1

POD #2

Emergency Spillway

Principal Spillway

Perrydale Road

Irrigated Area in the NW1/4, NW1/4 -



3.00 Ac



2.96 Ac

Irrigated Area in the NE1/4, NW1/4 -



0.04 Ac



POD #1- Diversion Point #1 and Flowmeter

POD #2- Diversion Point #2 and Flowmeter

1/4-1/4 Section Line

DLC Boundary Line

Taylor Reservoir #1 is 351 feet south and 1,329 feet east, Diversion Point #1 and flowmeter (POD #1) are located 669 feet South and 1,173 feet East, and Diversion Point #2 and flowmeter (POD #2) are located 359 feet South and 1,145 feet East from the northwest corner of Section 28, Township 7 South, Range 5 West from the Willamette Meridian. The irrigated area and Taylor Reservoir #1 are located within Polk County Tax Lot 400 and 408, John M. Wilson DLC 50, the NW1/4 and the NE1/4 of the NW1/4 of Section 28, Township 7 South, Range 5 West from the Willamette Meridian.

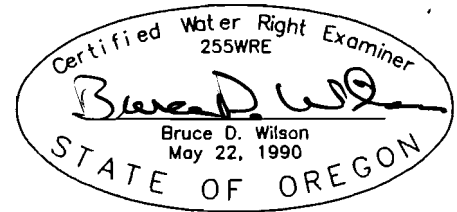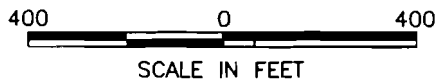

NOTE: THIS MAP WAS PREPARED FOR THE PURPOSE OF IDENTIFYING THE LOCATION OF A WATER RIGHT ONLY AND IS NOT INTENDED TO PROVIDE LEGAL DIMENSIONS OR LOCATION OF PROPERTY OWNERSHIP LINES.

# CLAIM OF BENEFICIAL USE MAP

FOR

Application No. R-86436 & S-86784

Permit No. R-14263 & S-54397

in the name of

## Scott and Candace Taylor