

20 21

29 28

Webb Lane

DLC 53

DLC 52



Tax Lot 405

1,145'

1,329'

Tax Lot 407

Tax Lot 406

Tax Lot 400

POD #2

Taylor Reservoir #1

POD #1

Tax Lot 408

Tax Lot 409

1,173'

DLC 50

DLC 68

Perrydale Road

351'

669'

669'

UNNAMED STREAM

UNNAMED STREAM



- Irrigated Area in the NW1/4, NW1/4 - 3.00 Ac
- 2.96 Ac
- Irrigated Area in the NE1/4, NW1/4 - 0.04 Ac

POD #1- Diversion Point #1 and Flowmeter
 POD #2- Diversion Point #2 and Flowmeter

1/4-1/4 Section Line

DLC Boundary Line

Taylor Reservoir #1 is 351 feet south and 1,329 feet east, Diversion Point #1 and flowmeter (POD #1) are located 669 feet South and 1,173 feet East, and Diversion Point #2 and flowmeter (POD #2) are located 359 feet South and 1,145 feet East from the northwest corner of Section 28, Township 7 South, Range 5 West from the Willamette Meridian. The irrigated area and Taylor Reservoir #1 are located within Polk County Tax Lot 400 and 408, John M. Wilson DLC 50, the NW $\frac{1}{4}$ and the NE $\frac{1}{4}$ of the NW $\frac{1}{4}$ of Section 28, Township 7 South, Range 5 West from the Willamette Meridian.

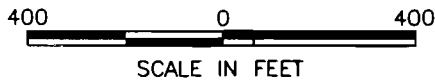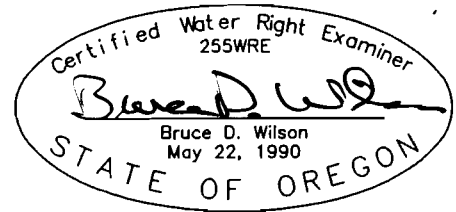

NOTE: THIS MAP WAS PREPARED FOR THE PURPOSE OF IDENTIFYING THE LOCATION OF A WATER RIGHT ONLY AND IS NOT INTENDED TO PROVIDE LEGAL DIMENSIONS OR LOCATION OF PROPERTY OWNERSHIP LINES.

CLAIM OF BENEFICIAL USE MAP

FOR

Application No. R-86436 & S-86784

Permit No. R-14263 & S-54397

in the name of

Scott and Candace Taylor