


T.35S.,R.10E.,W.M.

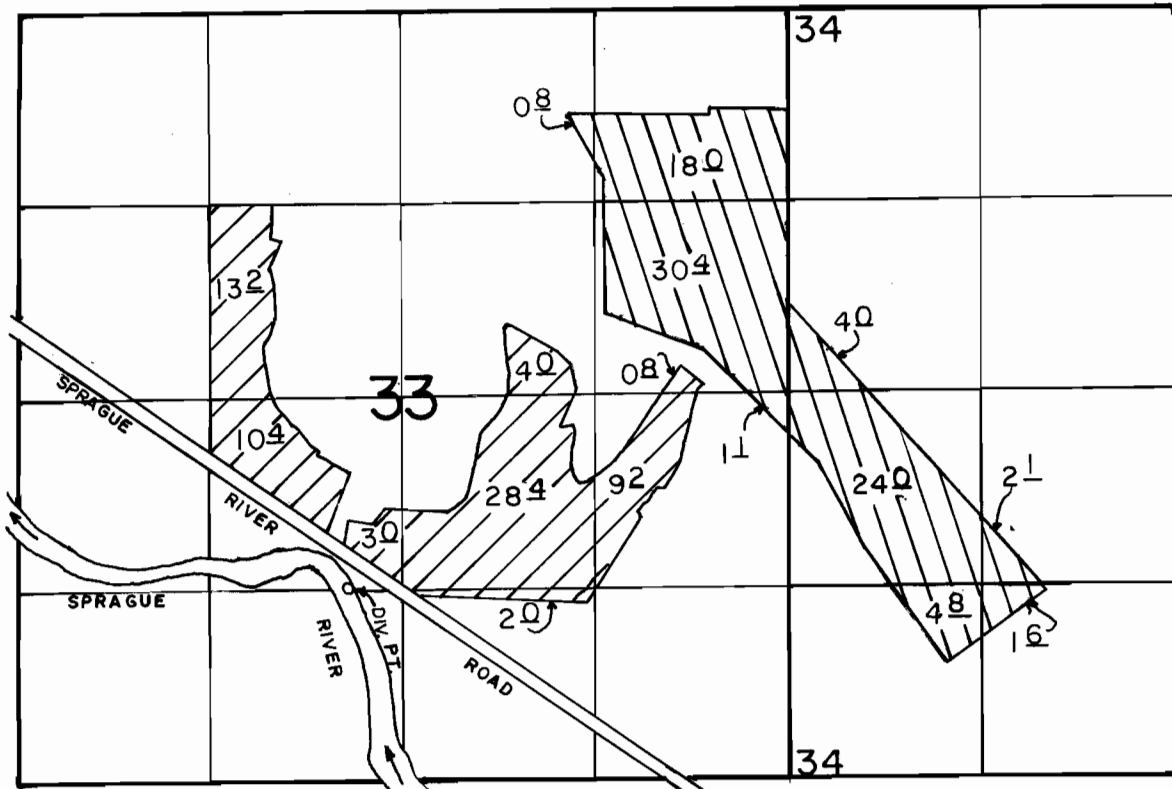

DIV. PT. LOC.: 1330 N. & 2260' E. FROM SW COR. OF SEC 33.

SCALE: 1" = 1320'

**FINAL PROOF SURVEY**  
UNDER

64990                      47604  
Application No. 63590 Permit No. 46670.....  
IN NAME OF



ORVAL J. AND ELENORE V. EKSTROM

Surveyed SEPT. 24 1991., by B. W. BISHOP.