



REGISTERED PROFESSIONAL ENGINEER
 JUL 5 1921
 JACOBSON & MALINE

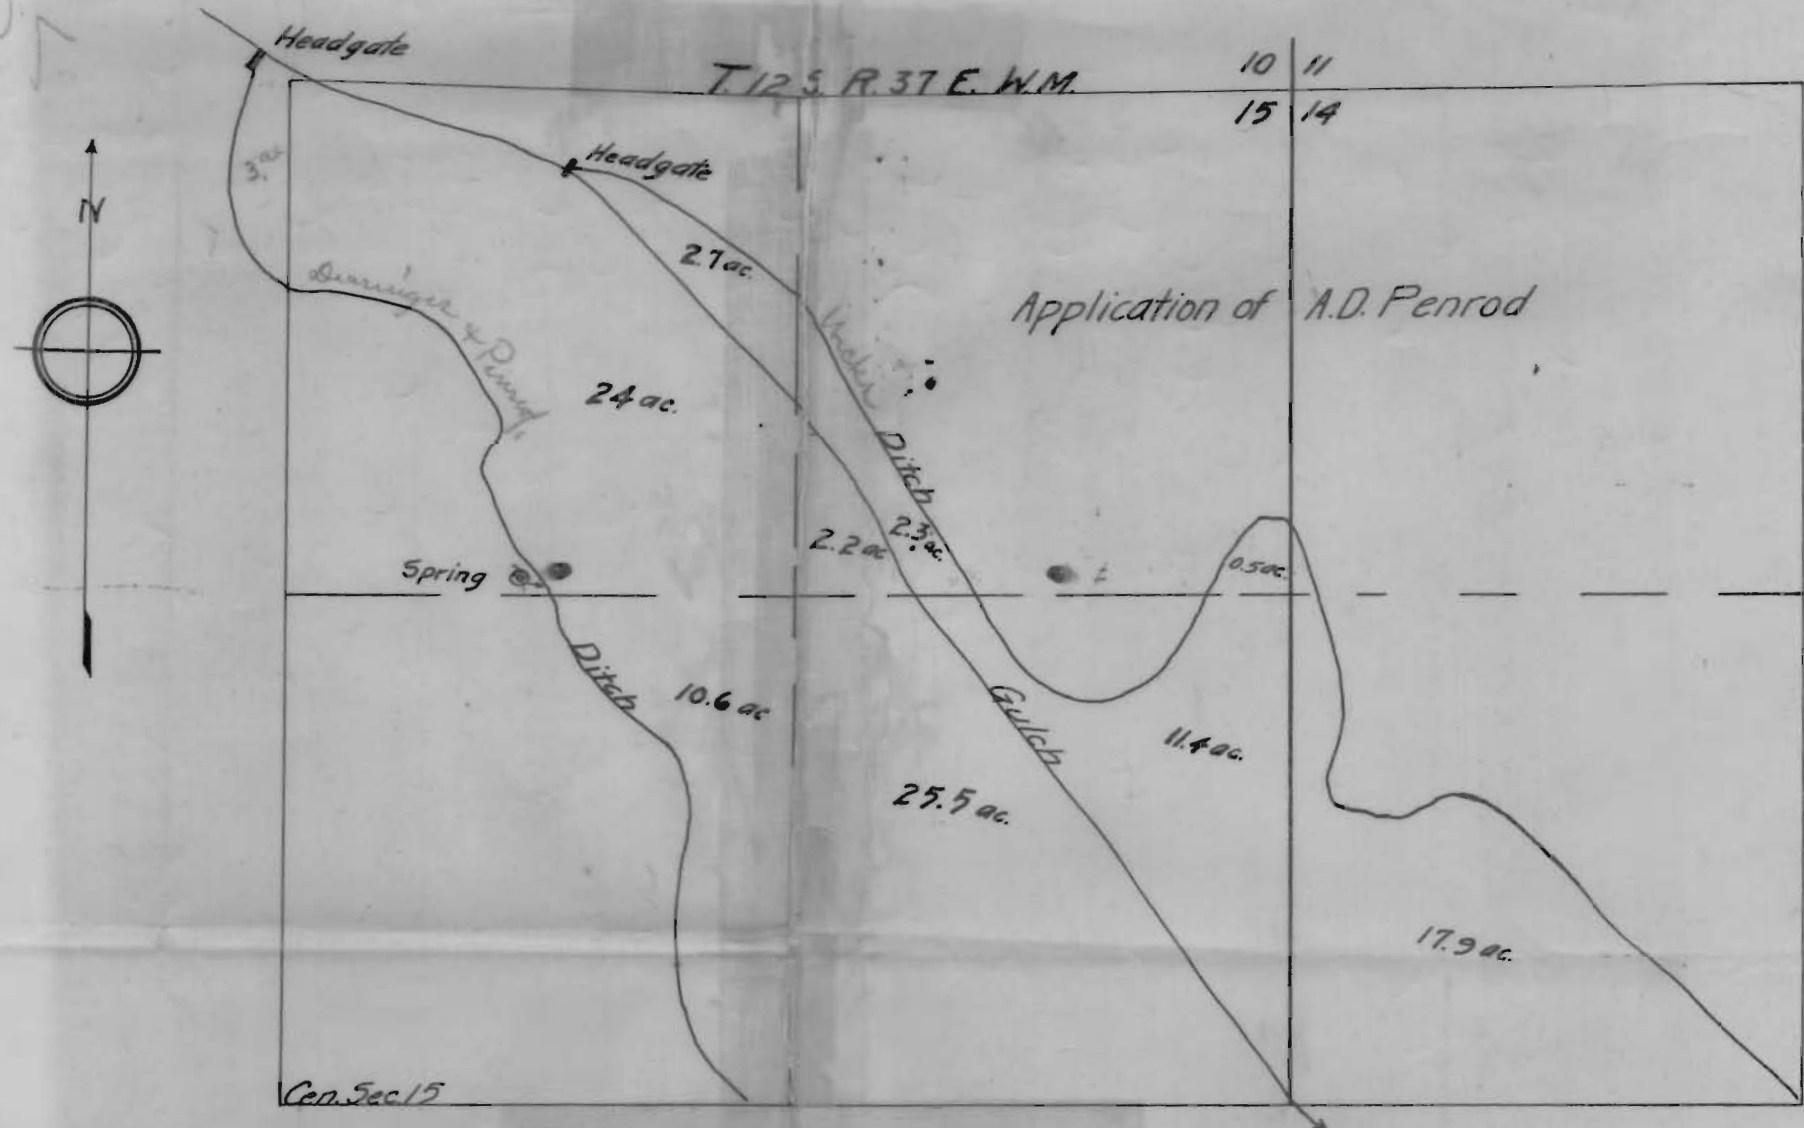

I, T.L. Borman, of Baker, Baker Co.,
 do hereby certify that this map was made
 from the field notes of an actual survey under
 my supervision, June 29, 1921, and that it is
 a correct representation of the accom-
 panying application.

Map
 Showing
 Penrod's Seepage Water Ditches
 Scale 1" = 500'

Application No. 7914
 Permit No. 5147

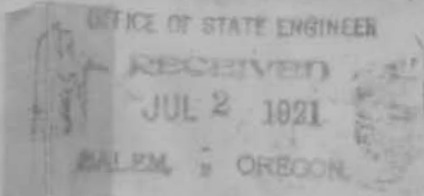

2107