


T.36S.,R.11E.,W.M.

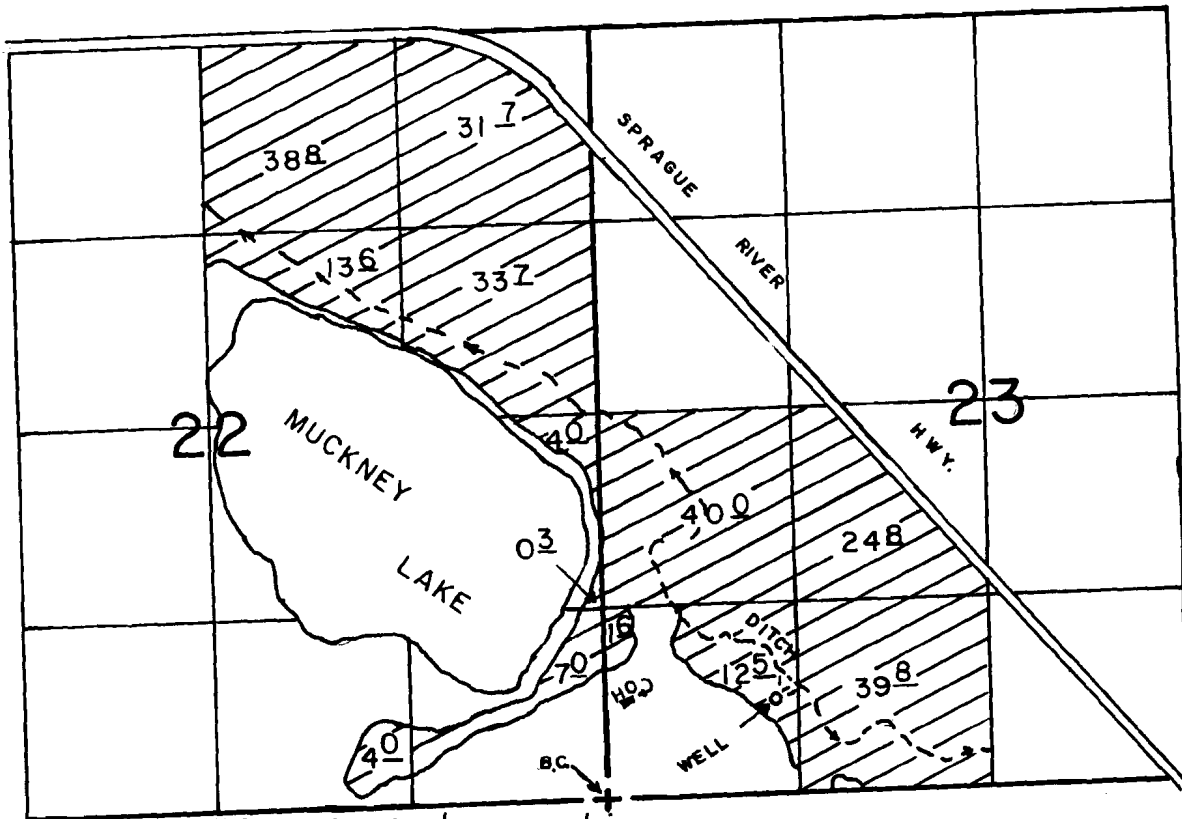

WELL LOC.: 640' N. & 1160' E. FROM SW COR. OF SEC 23.

SCALE: 1" = 1320'

FINAL PROOF SURVEY UNDER

Application No. G-10746 Permit No. G-10079..
IN NAME OF

.....DOMINC LA ROSA JR.....

Surveyed JUNE 5, 1991., by R.W. BISHOP.

Sprague River Wells

