


66624



T. 36 S., R. 11 E., W.M.

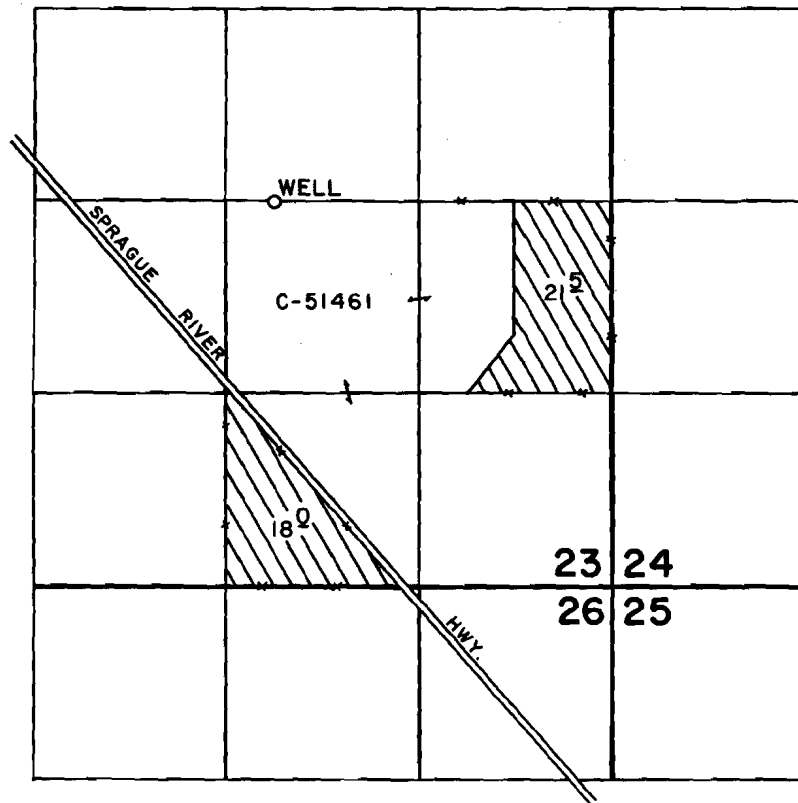

WELL LOC.: 10' S. & 330' E. FROM THE C. 1/4 CORNER SECTION 23.

SCALE: 1" = 1320'

**FINAL PROOF SURVEY**  
UNDER

Application No. G-10699 Permit No. [REDACTED]  
IN NAME OF  
**EDWIN J. & PATRICIA A. VIEIRA**  
Surveyed SEPT. 27 1989, by B. W. BISHOP...

*Sprague River*