


MAP *Whiskey Ck. & Moe*
 Showing Location of
 Turner-George Ditch
 in
 T.36S. R.11E. WM.
 Scale 1 in = 2000 ft.

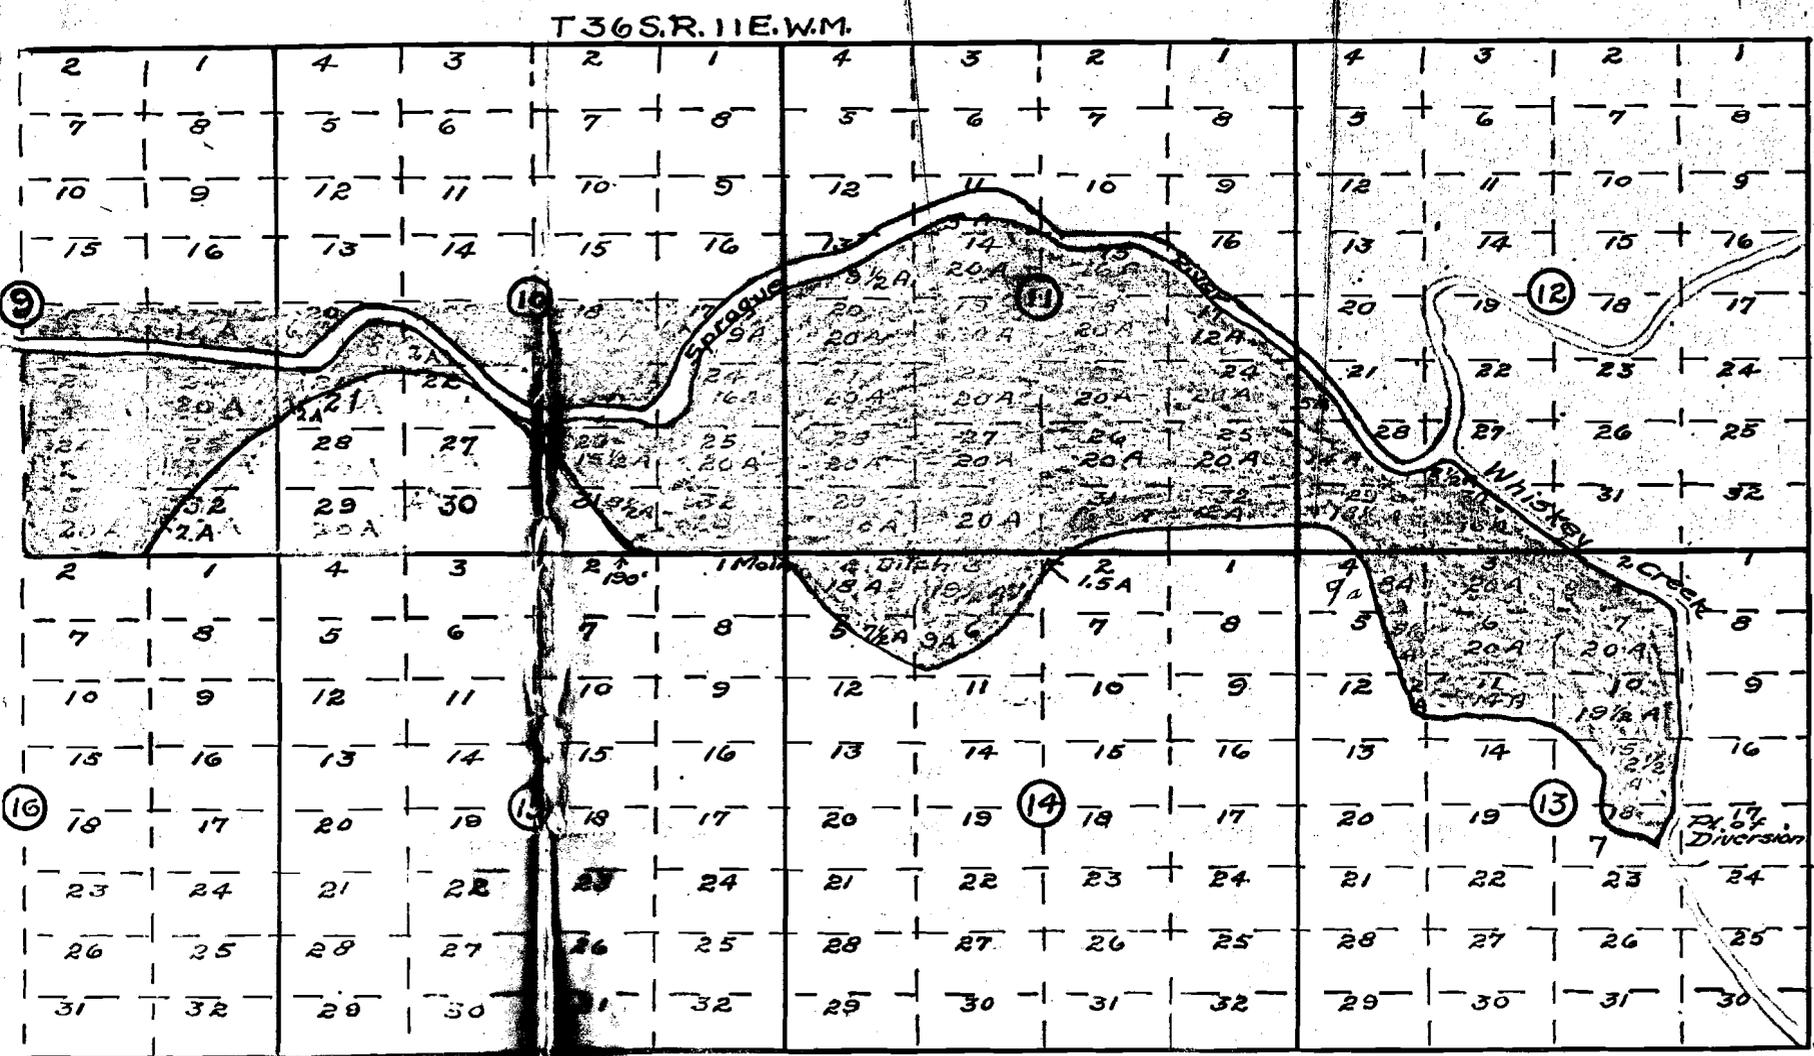

I, C.T. Darley, of Klamath Falls, Ore., do hereby certify that this map was made from notes taken during an actual survey made by me on March 1920, and that it correctly represents the works described in the accompanying application together with the location of streams and other ditches in the immediate vicinity

C.T. Darley Engineer.
 March, 1920.

C.T. Darley

Applic... 8052
 5184

8597
 5184