


Final Proof Survey
 IN NAME OF *Roy & Mary Anderson*
 APPLICATION S-70928 PERMIT R-11781
 APPLICATION S-70929 PERMIT 52148

DATE SEPTEMBER 14, 1997
 BY: WILLIAM J. RUPPERT
 P.O. BOX 1564
 MYRTLE CREEK, OR 97457

REVISED
 SEPTEMBER 25, 2003

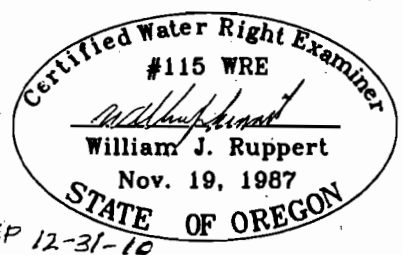

RECEIVED

EXP 12-31-10

SEP 30 2009