


T.2S., R.38E., W.M.

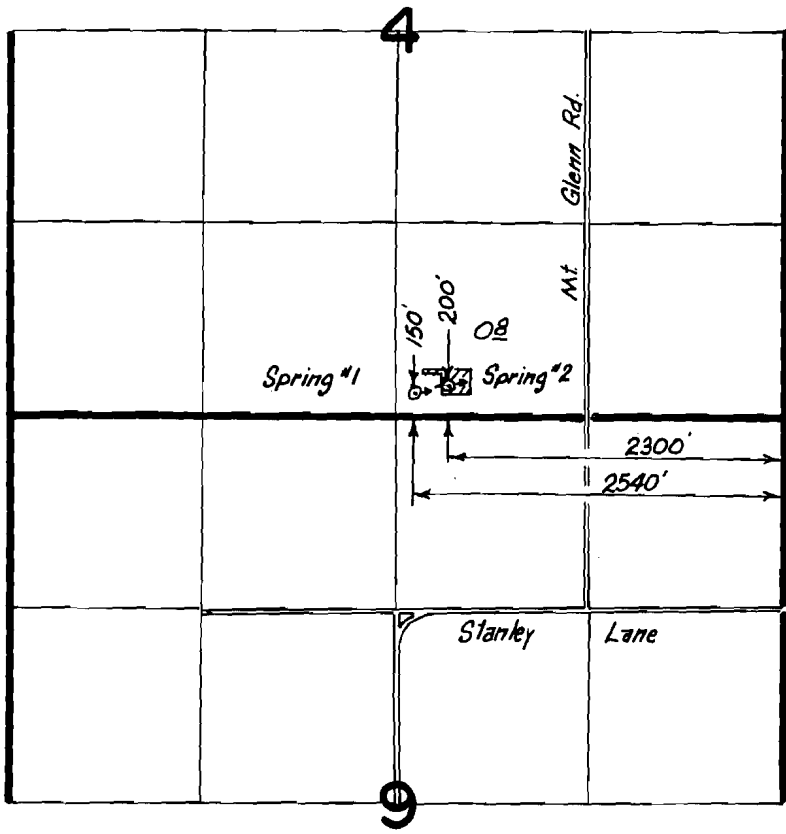

Scale: 1" = 1320'

FINAL PROOF SURVEY UNDER

R 59937 R 8227
 Application No. 59938 Permit No. 45469
 IN NAME OF

.....GLENN D. & ANITA F. McINTOSH

Surveyed 6-23 1987, by Vern Church....

12-18-09 JWC
 41061-179-108R KK 1/89