


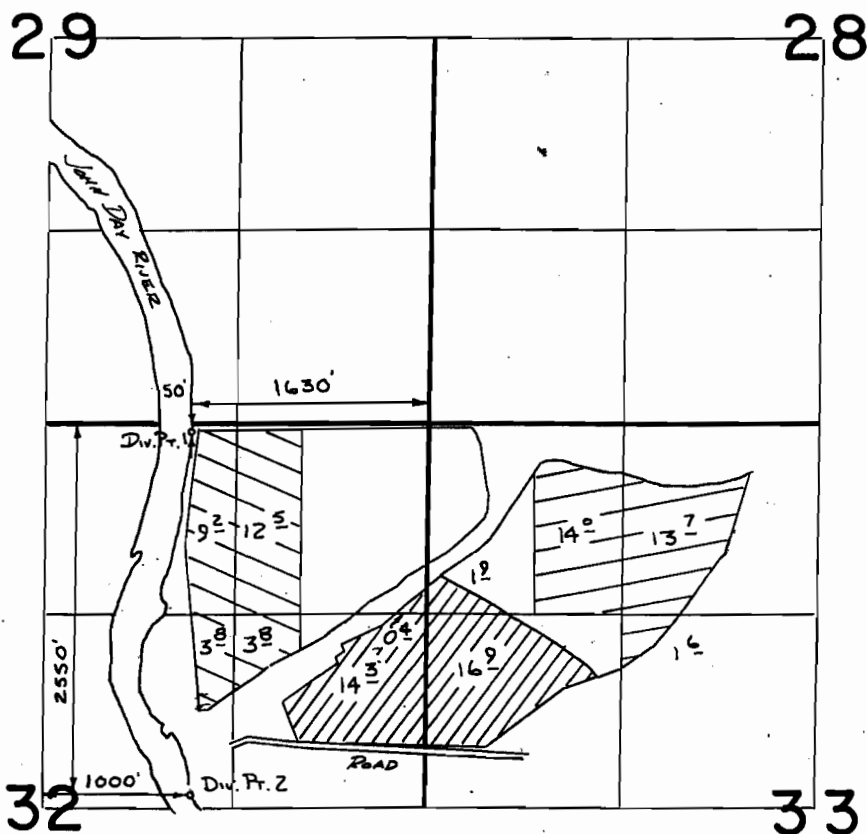


T. 7S., R. 19E., W.M.



SCALE 1" = 1320

 T-4752
  T-4751
  P#44315

FINAL PROOF SURVEY UNDER

TRANSFERS 4751, 4752, 5295

Application No. **58592** Permit No. **44315**
IN NAME OF

WILLIAM J. BOWERMAN JR.

Surveyed *5-12* 19*37*, by *V.L. Church*